X 2-22-73 set 5/8 x 2' rod pulled all grings set pursuant (1)
4-26-1973 set CM in place 4 rod above 1" stake x 3'
cor'd 3-13-75

1/4 Corner 15-16 Pleas. Grove 105-13
(#531506

6-1886 Hunter P410 no 399 & 15 N Burgan, R Folcork
Corner gone, B Tree gone. set stone as corner N & L
39.90 with B.T. 4" hickory tree blazed west 18½ lks (12.2'
2633.4 645.15
— north set (stone 9,77½) (on line by dud.) then 10.17½ 671.55 to
found. 4-13-72) 1316.7 } found H-6-72
— 1/16 north set stone & stake N & L 19.95 } for line east.

11-1886 Hunter P417 no 406 & 16 P. Redmond, N Levan.
found stone P410. & hickory B tree.

1-1894 N F Fraser P543 no 504 & 15 John Clark est.
found stone P410.

4-1895 N F Fraser P565 no 518 & 16 C Russell, S Tylor.
found stone P410 - Meas south 39.90.

11-1939 J Kerr P 544 B - B 16 P 58 - d 16 E Chase.
found boulder stone. - "treated same by a stone to the north, pumice" record and found correct
run line west to W 1/4 16. to check limestone
found at center 16.
- 1/16 west set iron stake as 1/16 corner and NE corner
gov't woodlot no 24. with RP. 6 (found 4-13-72 new RPs below
14" black walnut NE 10.7.
- set iron stake south of above 1/16 corner. 642.1'
with RP of 8" poplar tree 6' southwesterly

angle at center
thence S to E 89°53'
to 1/16 cor. north

10.7 due N to center 20" walnut E side with 2 16" sucker trees West.
125.5 NNE to center blazed 18" very tall straight oak
62.5 little S of W to center. 20" post Maple on east side back drop off.
61.94 due S to 30 D on E side 16" oak - easterly of clump of 3 big trees
above are references to 1/16 rod found. 1330.44 west to center. 16. by Cad 2.

#531506

Card # 2. 1/4 15-16 Pleasant Shore 105-13. (2)

4-17-92 Co surv. Corner plowed out in farming operations or golf course construction operations. found N.E. corner 16-a boulder with cross and sections marked on sides of stone. - ran random line south (very wooded L of stone) N end random cross on stone. - found boulder with cross under N-S fence as 1/16 corner set by Hunter. 6-1886 22.55 west of random line.

R.P. about 24' from nearest of 3 pines running west slightly North of due west of stone. station of stone 1316.95 R 1316.7.

- found woodlot stone with cross at 1990.17 R 1988.25 which lay 43.64 west of random. (34.04 ft on direct line). 1'GK

- if continued to 1/4 15-16. corner would lie 45.1 west of random. type which would make mean to S Ker 1/16 west 1352.16 R 1331.66

- in ignoring NE cor 16 and using 1/16 stone and woodlot stone

(over

As true portion of section line would place 1/4 15-16 West of true projected random 63.8 and 1333.46 from S1/4 cor 1/16 iron which proved this line very close to stone used by S. Kerr in 1939. - set 1/2" x 3' rod. as corner. until proven otherwise. (by proving or disproving NE16 by line running east).

RPs. ~~56.85~~ NNE to 16 D W side 6" iron wood in cut of fence.

~~55.6~~ 48.28. NNE. to 16 D W side wired up 14" elm in fence.

~~45.2~~ 57.31. ENE to 16 D S side knarly elm in clump of elms.

Corner seems to line with large trees running N 10° 0' 00" W.

No fence east. - Corner 63.8 west of projected orig true random.

Paul F. Kerr

5-72 believe Sec cor true corner by line from east and 1/16 corner may have been the one moved - using section corner and would set corner 1/4 15-16 would have came. 57.75 west of true random. or 6' east of corner as set.


Card # 2. 1/4 15-16 Pleasant Grove. #531506 (3)

2-22-73 reset corner again with 5/8" x 2' rod.

New RPS. (2) 48.28 NE to 20D nail NW Side wired up 14" elm in fence.

(1) 57.37 E to 16D nail on S side Southerly of clump of scragly elms

above B tree to eye line of PP west corner 2'± S

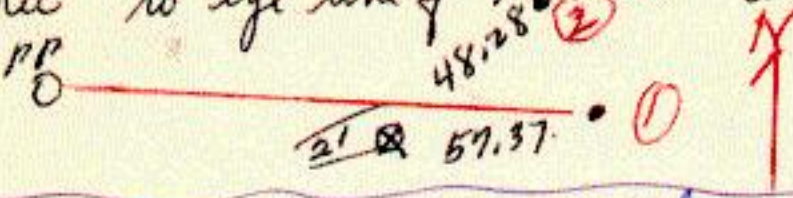

4-26-73. set C/M over 1" x long pipe 3'+.
set C/M down 4" center C/M open. a little.
will some day figure how this corner lines north over
wood lot road and 1/16 stone.
- elec traverse from 9-10-15-16 (4-26-73) believe now
that stone correct as set. 1886.

Gov't Wolfs M.G. Karrick 1854
1/0.00 Set 1/4 steel. post
Elm 11 S 35 W 13+
Wh. Ir Oak 8 S 27 E 18

(1941) CHD (BL127)
Set ? equal
distance between
section corners
Rp's 22.3' E of S box
culv. wing
26.7' SE of N box culv. wing

Jan, 1864 P.C. Compton Pg. 79 No. 118 used 1/4 Corner to Subdivide N.E 1/4 sec. 16 into 10 Acre lots. Compton States that Each 20 rd Meas North Fell Three links Short giving 19.88 Chs. For Each 1/4 Mile.

(5/23/83) M. Patterson T. Ferguson Retied Cor.

20 D on N.W side	6" iron wood	E N.E.	49.7
30 D on NW side	18" Elm	N.N.E.	48.55
160 in old stump		E.	57.45

<I.M. lies 90° out in golf course