X 4-6-72 set C.I.m. over Bolt with glass (1)

#531704

1/4 corner 17-20 Pleas. Grove 105-13.

5-1856 Hunter P4 no 7 S 17.

Corner used for line north to sub-divide section 17.

- Meas north 39.95 2636.7

11-1939 J Karr P 542B - B16P57. S 20 E chase.

found, set, or accepted corner an iron bolt in quarry.

- Meas West 2645.5 To twisted iron shaft.

- 1/16 east iron bar set N & L (2715.82. Meas S 1/4 sect) or 13 57.91

RPs above 1/16 - N 69°30'W center 6" hard maple. 22.0'

N 21° W " 13" basswood 22.5'

S 12° W " 18" hard maple 57.0'

Believe Corner in Quarry set on N line 20 where 1/4 line from S. intersects

over)

1/16 south set iron M&L 1313.57 to stone, Center 20.
– iron set 142' north – then iron 670.98 east
leaves 7 or more iron property corners in NE ¼ 20
see B 16 – P 57 JKell.

RP.3 to ¼ 17 – 20. P 542 B below plat.
16" elm. N 63° E 89.6'
set transit on N.E corner of West curb of Bridge
No 3571 – Deflect 39°50' from line of said curb. NW
projecting distance 208.0 to ¾" iron bolt driven
into rock bottom of old quarry.

---

on 9-1933 book 9 page 1. Stone centers and S ¼ 20 were found
and line projected north to find in fill in old quarry – NW corner.

Card #2. 1/4 17-20 Plane Surv 105-13

field book #16 page 71 J Karr 12-8-1939. (2)

#531704

set 3/4" iron and lath on N line NE 1/4 20.

East of iron in quarry 1/4 17-20 264' (for line south to? reason unknown).

- ran line from 1/16 iron betw 1/4 17-20 and 16-17-20-21 and meas. south, 2627.76 several Δ meas.

- on this N-S 1/16 line set iron at (1) 594.0, then iron at (2) 398.15 then iron at (3) 321.26. Total 1313.41. at 1/16 corner.


M & L. is 1313.76

set iron 676.5 west of (3) and.

" " " " " (2) 2 irons 321.25 N & S.

over

1/16 iron betw 1/4 17-20 (iron in quarry) and 16-17-20-21.
shown as iron bar set M&L 1357.91.
22.5' N 21° W to center 12" basswood
22.0' N 69°30'W To center 6" hard maple.
57.0' S 12° W To center 18" hard maple.
P 59 B 16 shows lot staked in extreme SE corner S 17.
sleigh shoe set as SW corner M&L to 1/16 corner set a 7/8"x5' red.
678.97' west 4" pin oak NE 5.25'
- set 3/4" iron pin as NW corner 322.71 north

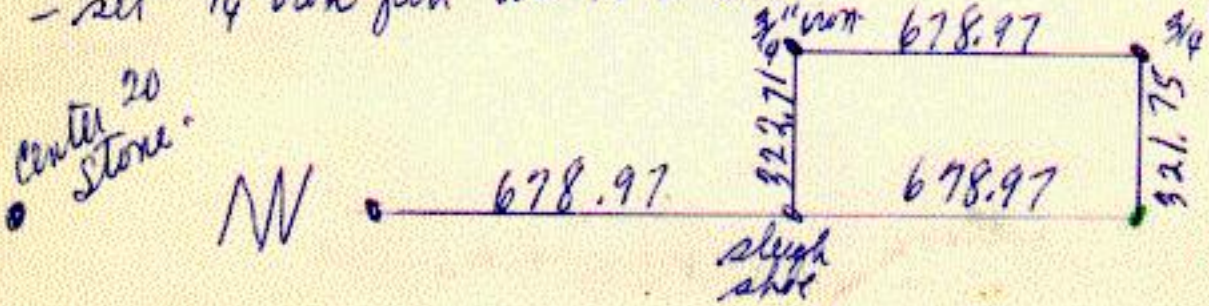

Card # 3

¼ Corner 17-20 pleasant Grove 105-13

R. P.'s #531704

•Center	6" Blazed Elm	North 9.3'
Center	6" Blazed Elm	East 24.6'
Center	9" Blazed Elm	South 9.5'
Concrete nail driven in Rock (up 3')	4' East of North	18.26'

~~March 9 1981 set post + sign~~

5-6-76 Took new R.P.'s to CIM

Spike and CSD	6" blazed Elm	SE 24.83
Spike and CSD	6" blazed Elm	NE 9.25
Spike and CSD	9" blazed Elm	SW. 9.45

1900 Rob't Fraser (Fd. BK #15 P 21-22) Used point M&L as corner

1883 Tom Hunter (P. 386 No 377) set corner at intersection

of lines blazed West and South. Meas. E = 41 chs

Extensive subdivision of E ½ Sec 20

Govt Notes M.G. Karrick 1954 Emsi Ranch
40.00 Std temp quarter Std post 17 + 70
Wrsl on true line between Std 17 to 20
40.00 Std 1½ Std post V, 0 33'
No trees near suitable for bearings
trees to mound with trench & pits
& charred stake and osage orange
N, E & S, W.

Ken Prop. Cor. 264' East of ¼ Cor. 17-20, ■ Set 12-8-1939, Book 16, Page 71, 5-20-1982: Found 3/4" iron set by Ken but did not measure.

Card #4

1/4 Cor 17-20, Pleasant Grove, 105-13
#531704

5-20-1982, 1/16 East: Found 7/8" rod set by Kerr (up 6")
and identified Brg. tree, a Hard Maple N69° 30'W
22.0 Ft set 12-9-1939, Book 16, Page 59. Blazed
tree again and blazed another Maple N'ly 36.6
Did not measure in.

5-20-1982, Kerr Pt. 471.0 South of 1/16 E. of 1/4 Cor 17-20:
Found spike on [redacted] bank (above drop off) on
South side of woods road. Did not measure in.