
8-3-1964 set C I N. over steel rod. #531805 (1)
9-21-71 reset rod as corner after grading.
section corner west 18-19 Pleas Grove 105-13.
10/25/91 set 1/2" Pipe w/ cap over rod set 1971
east 13-24 High Forest 105-14.
6-1886 Hunter P411 No 400 S 18 Henry Woitte
found stone with stake by side also found in unrecorded Hunter survey 1876. This stone set by Freeman at site of orig corner.
B trees gone even in 1876 accepted stone as found
- Meas east 39.82 to stake found.
- 1/16 north set stake M & L 19.90.
- staked church and cemetery grounds. 10½ rods east from town line section corner on section line east. and 10 rods north & south. survey in detail → over)

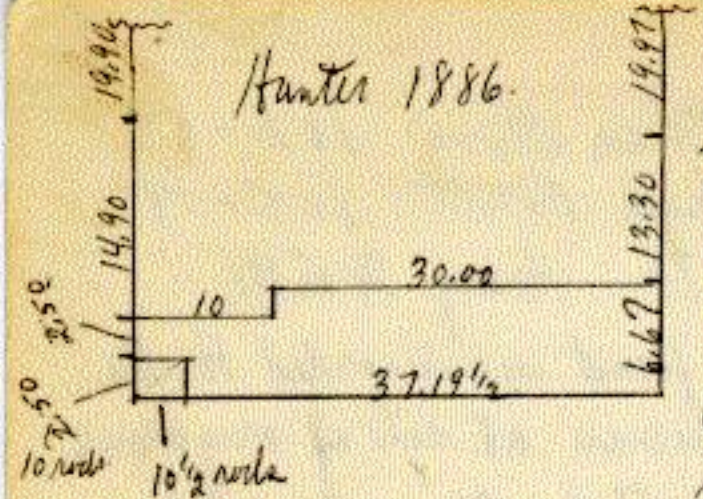

8-1964. J Kelly found hub & nail used by Co Hwy Dept in road layout in 1947. Quite a cut by cemetery so orig stone could not have survived road curves sharply soon after above corner to avoid gully in valley crossing then straightening out by W'ly 19.

PPs. ~~Disc on large Cedar cor post (orig tie)~~ ~~W & W~~ ~~Gone~~ 9-71 ~~34.05~~

Center 4 iron staff Cemetery corner post	E	39.15
" " " " " "	NE	121.7
NW cor of base August Schoenstein gravestone	NE	67.35
3/4" iron stake in woods.	ESE	65.73

Angle from iron stake above to cross on south side of John H. Engle grave stone to section corner ~~104°30'~~ 104°02' 1971 Record.

#531805 (2)

Card #2 West 18-19 Plea Grove 105-13

Co to D B323 1967 found C1M.

New RPS - ~~Sp D in fence post~~ ~~NW~~ ~~49.54~~
~~Sp D " cor " "~~ gone. ~~W~~ ~~31.67~~ (9-71)
New 60 D in 24" oak ESE ~~55.97~~ 56.18
corner lies 5' ± east of center traveled road.
34.0 east to Top SW corner footing for wall (now exposed)
3/4" iron in woods as previous ESE 65.73.
NW corner. base August Schornstein gravestone NE 67.35
Angle now from Cross L side John H Engle grave stone
to section corner 104° 02'

(over

9-21-71. set short rod in road replacing corner destroyed in extensive road change recently. Referenced rod in edge woods. bent in road construction. new angle erase in John H Engle gravestone to corner as set. 104°02' 1964 104°20'
orig county angle never proved 98°37'.
other RPs (over card)

1943 Book* 137. page 56 Co. Highway Department

Corner gone- set 2"x2" stake assumed
Rp disc in oak SE 56.2'

Gone Notes
[illegible] -- [illegible] -- [illegible] 13-18-N-24
Black Oak 5 N 72 E 12
Black Oak 5 S 50 W 56

SECTION CORNER W 18-19 Pl Grove 105-13 (3)
E 13-24 High Forest 105-14
10/25/91 County Surveyor set 1" sq pipe/cap
over 3/4" iron set in 1971 in black top C.R. #20
Rp's & CR #20, east 12.5'
& field drive west, north 24'
SW cor. So. end retaining wall, SE 50.39'
#531805