X

#532004

(1)

1/4 Corner 20-29. Please Drone 105-13

11-1883 Hunter P386 No 377 E½ S20, E Colo etal.

Corner not used in this survey, but on notation that center had been set and referenced by Mr. Freeman, surveyor who used S 1/4 20 in this work.

5-1901 W Fraser P10B, S 20 town board.

found stone and stake set as corner.

-1/16 north set stake N 0 L. 19.82. 130 E. 12

-1/16 center S W 1/4 20 set stake N 0 L 20.03 on E-W 1/16 line.

(over)

12-1939 J. Kerr P542 B- B 16 P57. J Chase estate.
stone boulder. – blue boulder 7X12 x 5 with mark on top
packed in limestones at fence corner.
– Meas west 2627.37

9-1933 J Kerr fieldbook # 9. page 1. Saline survey.
"found center of section 20 105-13. and from there went to the
S¼ which is a corner post. Ran random line north to the
north line of section, did not find anything of the N¼ cor. as
the point came in the northwest corner of the quarry. set no corner.

12-16-1939 J Kerr. fieldbook # 16 page 75 Chase survey.
"went to S¼ 20. Cor. F. post is the corner. set blush
gray boulder. 12" X 7" X 5" with mark on top packed in limestone
chill. set on top & bottom of old post."
– found stone station 6+43.3 west. which was used for
line west (S¼ 20 over stone) to set N-Sing. of 19-20-29-30.


#532004

(2)

Card # 2. 1/4 20-29. Pleasant Grove 105-13
-over for road survey by Jr Fraser 5-1901. in SW 1/4 20.
3-14-73 ran transit with elect mtr from 1/16 iron set
by J Kerr north of center to checking iron rod set 582.66
on line north of center - cont south to J Kerr stone at
1/4 20-29 easily found by corner post which could have
been woods fence north? and easily coned to east rod
as easement lane in that location. a poorline fence
ran south 1 rod east but this land common.

4-13-73 went to corner probed and dug easily-found
Nothing - may accept J Kerr stone as corner and set C/M.
as corner link from center reproduced by J Kerr. 1/16 corner
north and iron set


Road laid out for Pl. Gr. town board.
by Wm Fraser Surveyor. Book B Page 10-11.
5-1901.

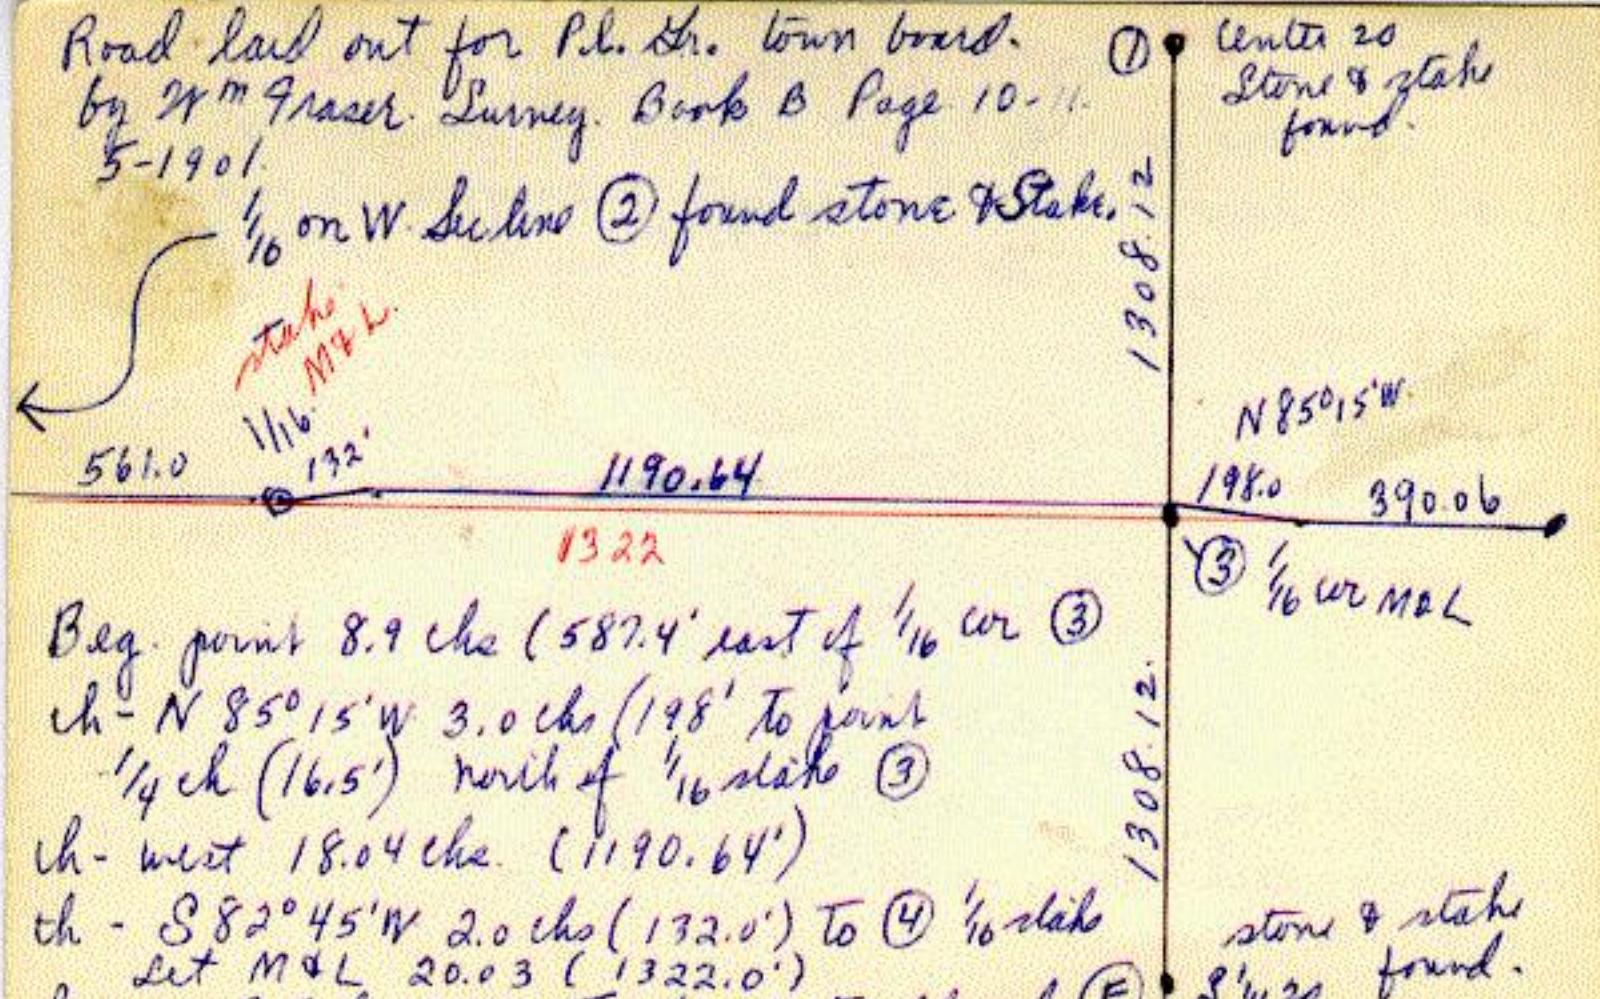

Beg. point 8.9 chs (587.4' east of 1/16 cor (3)
ch - N 85° 15' W 3.0 chs (198' to point
1/4 ch (16.5') north of 1/16 stake (3)
ch - west 18.04 chs. (1190.64')
ch - S 82° 45' W 2.0 chs (132.0') to (4) 1/16 stake
Set M & L 20.03 (1322.0')
ch W 8.5 chs 561.0 to intersect center old road.

Card # 3 1/4 20-29 Pleasant Grove 105-13 (3)

#532004

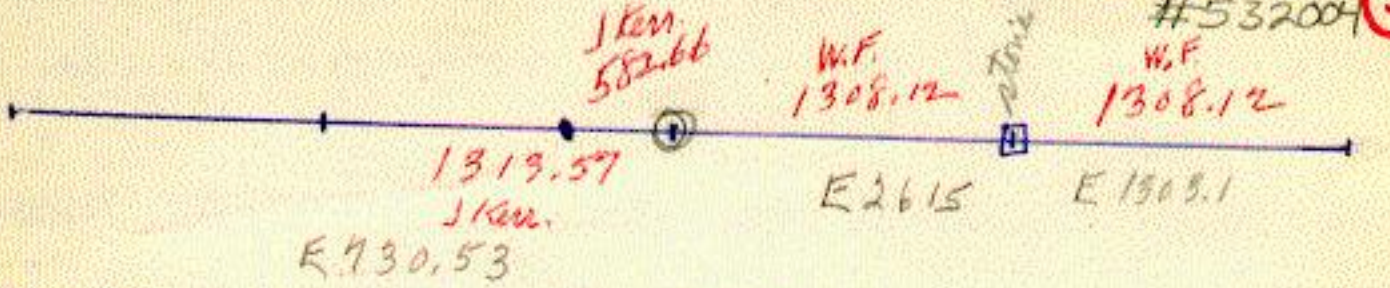

Reset Center with Rad from J Kerr Data

Gov't Notes M.C Karrick 1954 E 0.51 Ramhurst 79

110.00 Set temp 1/4 Set post

West on true line between Set 20+79

110.00 Set 1/4 Section post

Blackoak 12 S 10 W 70

Bur oak 10 N 45 W 61

7-24-1979 Dug from Kerr boulder South 2½', North 4½', and East 12'. Found nothing. The clay was only down 1'.

7-25-1979 Replaced Kerr stone with 16" CIM over a ½" x 16" Iron. Set survey marker sign and post 1.25 West

RP's: Spike and CSD in NE side 12" Twin Blue Oak NNW 11.89

Spike and CSD in North side 24" twin Black Oak NW 67.60

Corner falls ±6' East of old fence North and directly under newer E-W fence.

This just seems too much.

1/4 Cor 20-29 Pleasant Grove 105-13 (4)

#532004

1/16th West: 7-18-1979 There is no fence corner left here now, but we were able to line up with a fence East, a fence South, and the remain of a fence ridge north for a point to measure too.

1/64th West: 7-18-1979 There are two new corner posts here with fences running N-S-E-W. We did not find the stone referred to by Kerr and we did not dig for it.