X

#532005 (1)

Section Corner 19-20-29-30 Pleas Grove 105-13.

5-1901 H Fraser P10B L20 Town Board.

may not have used corner, but found stone & stake plainly placed as 1/16 corner north which was accepted, used 1/16 corner to lay out road east.


12-1939 J Kerr B16 P57 L19. Erwin Chace.

BK.16 P.75 says 3/4" iron and P75

3/4" bridge bolt packed in limestone 18" below surface. P542B.

- Meas east 2627.37 to boulder ~~found~~ set at L1/4 20. (P75B16)
- 1/16 north M & L 1313.75. no description
- Meas west (P548B) 2627.37 to boulder L1/4 19. over RPs.

to find SW corner 20 proceed as follows.
Meas 42.5 North to clump willows and
meas 51' west to clump willows to find
iron bridge bolt in pasture. Place transit
on bolt and orient
16°03. on center windmill Tower nearby farm about
41°49' on east side conc silo farm 3/4 mile
then turn transit AZ 174°26' and away.
meas. 270.42 to find corner.

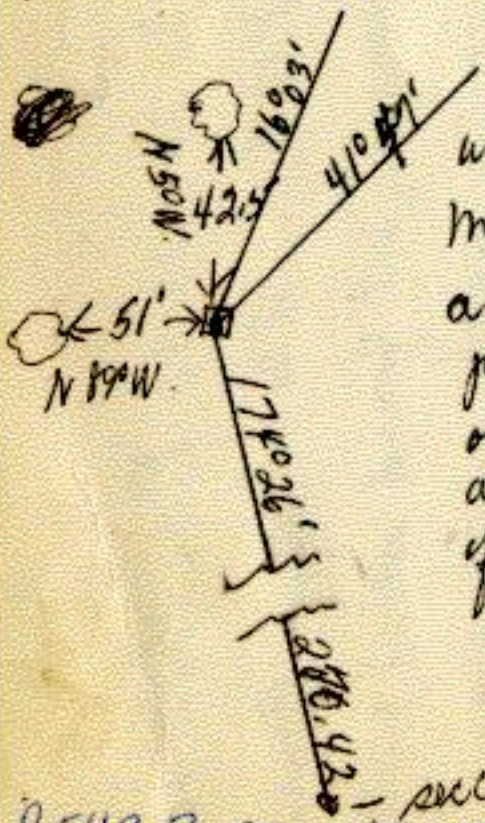


Note this sec cor
was gone. set corner
midway SW1/4 19 & SW1/4 20
and on a line
projected from SW1/4 20
over a stone found and
accepted on the south line
of the SW1/4 section 20.
3-1972 not sure of stone
at 643.3 west of SW1/4 20
used as line or not
may be section corner
set directly N&S
2627.37 or
2627.5 SW1/4 19-20.

P543 B says corner
set midway SW1/4 19 & SW1/4 20 and
on a line projected from SW1/4 20
over stone on S line SW1/4 20

#532005 (2)

Section Corner 19-20-29-30 Pleasant Grove 105-13

7-12-1979 Found Kerr's 3/4" reference iron from Willow clumps described in 1939. Measured 270' SSE into cultivated field and dipped a 3/4" iron as sec. Cor. packed in limestone 1' deep. We tied both these irons into our traverse. We set a 5/8" rod and cap 1' South of the E-W pasture fence as the traverse point from which the irons were shot.

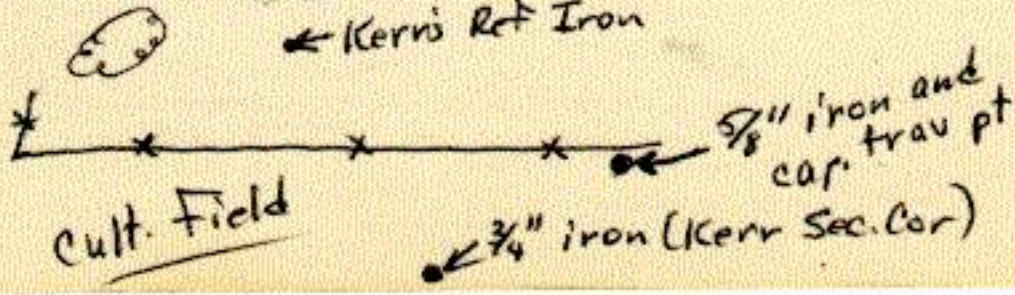

See Blue Book for history done!

Pleasant Grove Section 19-20-29-30 (3)
#532005

Coal Notes on Back

Coal Works M.G. Karrick 1854

80.00 Std Post for corner to Std 19,20,21,22

Buck 7 S 38 W 180

" " 12 N 57 E 151

" " 8 N 19 E 41

" " 12 S 71 W 91