8-21-1964 set C I M in open field, stones & iron below ①
#532805
section corner. 28-29-32-33 Pleas Grove 105-13
for 1893 W Fraser P528 no 493 S 31-32-33, E rock, C W Iles found stone answered & accepted by all parties C Bruster.
as set at site orig corner stake. left as found
- meas south to M & L set 39.94½. 12636.4'

4-1942 J Kerr B 27 P4
used stone to set plow lathe - plowshare south, M & L 2633.9'

8-1964 J Kerr for preservation of corners. work.
found after meas from NW cor 32. and very extensive digging 10'x 20' -
- meas west 5266.33. to corner found (now C I M. (Corey)

corner comes in open field. some 80 rods East of T road intersection.

RPs - to center of natural draw or water way S. 55' ±

Top of windmill in farmyard AZ 294°26'

" " silo " " barely visible AZ 208°53'

Trees in fence row on section line E AZ 89°35'


no fences in any direction. rise in land to west making line hard to run in. - also rises N & S.

9-1930 Co H D. B57 P43 found limestone on edge.
Meas south 5268.4 to 1/4 cor 2633.2.
Meas east 5280.6

Sec. Corner 28-29-32-33 Pleasant Grove 105-13 (2)

#532805

5-30-78 Found bottom half of Kerr monument in place 18" deep in cultivated field. Set a ½" rod on the East edge of the N-S gravel road running N-S ¼ mile West of the corner. Turned an angle left from the rod found in ℄ T.H. 30 near the W. ¼ 33 to the monument and measured distance as follows!

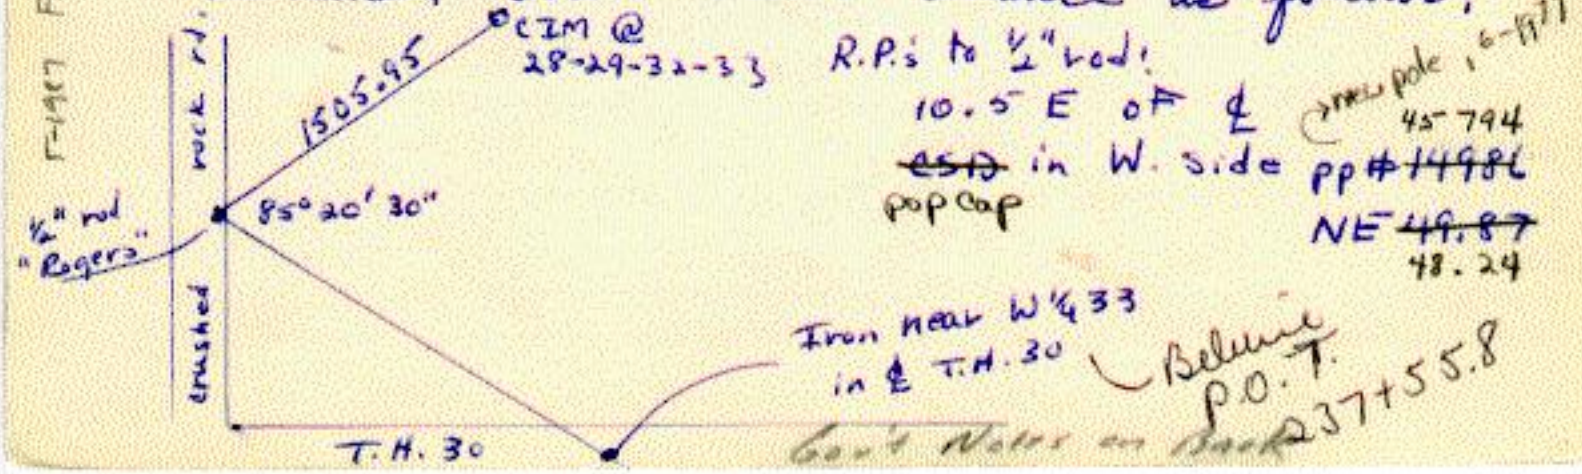

Gov't Wolts M.G. Karrick 1851
80.00 Stl post to cor. Scr't 28, 29, 32, 33
Bur OAK 10 S80 W1/61
Dug trench
5-21-87 Fd CIM in Field OK.