South 1/4 Corner Sec 34 Pleasant Grove 105-13
Also N2-3 Sumner 1.80 = 118.80 #533404 (1)
Government Survey tie of 1.80 Chains West
to a stone 3 X 13 X 14 at North 2-3 Sumner
Township, Fillmore County. Set c.i.c. /p² 11/13/84
11/9/84 S1/4 Cor 34: Corner falls in open field. Fences removed and all plowed over. Aerial photos show there was once fence North, West, and East here and a fence running South 150'± 10' West of the ± Note. Set up a point midway and on line between S Sec Cor 33-34 (CIM) and S. Sec. Cor. 34-35 (CIM) Line from the N1/4 over the fence at the Center 34 came 5' West of M&L and line from SW 34 over the fence at the 1/16 E came 6' South of M&L so we dug SW1/4 of the M&L pt. first.


Found a fence post hole and dug North to establish fence line. Found one more post stub 7' North of the first. ~~Did not find any more post stubs North of the first.~~ Did not find any more post North of this. Dug South and found the corner post and also the first post West of the corner post. Line of fence running N-S is ± 5' West of midway. On the SE'ly side of the corner post - appx 1½' SE - we found the stub of another post which began at the clay line and ran down 2'. It had an odd shape being pointed at the top and 5½" at the bottom and charred at the bottom and dug in. There was 1½' of black dirt over clay in the old fence line.

Dig as follows:



Did not have time to expand on C.P. area today.

S 1/4 Cor 34 Pleasant Grove, 105-13 #533404 (2)
Also N2-3 Sumner
11-8-84, N2-3, Sumner Twp: Dug as follows from point 118.8 West of odd post found @ S 1/4 Cor 34.

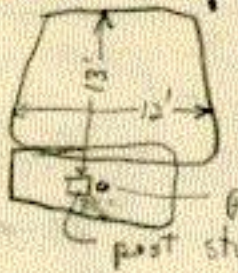


Found post stub appx 120.3 West of odd post. Did not find evidence of post store. Believe post stub only post in old E-W Fence.

11/13/84, S 1/4 Cr 34: Extended dig at corner post found for 8'+ East. Found another post hole 1 1/2" East of the odd post and another smaller post mark 2 1/2' East and 1' North of the odd post found 11/9/84. Found nothing further.

11/13/84 N2-3, Sumner Twp: Dug to find fence corner scaled on aerial photo 150'± West of fence @ S 1/4 34. Dug as follows:

(over)

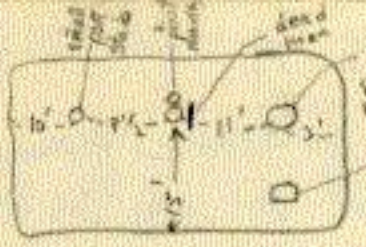

We first found a large limestone dug deep into clay with iron rod through it wrapped around pipe on East side. This all apparently a dead man for a post to the West. Found two post marks 1½' West. Took these marks as corner post area and dug West and found next post. Then dug South 15' to find evidence of fence South but could find no post or holes. Extended hole East on fence line and found large hole with post set in gravel brought in from somewhere. After digging out gravel and post found large rust mark 1.0 North and .3 E of post location, but was already so deep it only ran a few inches and could not tell if it may have been pipe mark or mark of Cast iron. Dug South from this post but still could not find fence post or marks, but did find a

S 1/4 Cor 34, Pleasant Grove, 105-13 #533404 (3)
Also N 2-3, Sumner,

11/13/84, N 2-3 Sumner continued: limestone 2½" x 9/11 x 16 lying flat 8½' South of post. Could not prove this to be a corner although within reasonable dimension for Govt Stone. (Post in gravel 151½ West of found S 1/4 34)

11/13/84, S 1/4 Cor 34: Dug 118.8 East of post set in gravel at N 2-3 and in E-W fence line but found nothing. Accepted fence corner found as best perpetuation of corner there and set a CIC/P2 on the corner at location of odd post stub (down 2')

11/10/84, 1/4 Cor 2-3 Sumner Twp: Found 1½" x 2½' x 30" Case iron. The iron was leaning N.E. badly because the C.P. to Fences E-W-S was dug in beside the iron.

Plumbed the iron up. It now stands on the S.E. side of corner post (up 1ft). The iron lines with fences South and East but is ±1' South of Fence line West.

RP: Spike in power pole East 19.61