9-15-1964 set C I Mower pipe site orig limestone (1)

1/4 corner 2-3 Hi Forest 105-14. #540206

6-1876 Hunter P299 No 294 S3 M Shanahan, J Lindugh found stake in mound & pits undisputed (no road then)

-16 west set marked stake M & L 19.81 (1307.46' to Center of 3 a stake set true outer lines.

Hunter 2-1872 P193 - 2-1876 P294 found stake in mound meas north 39.52 2608.32 south 39.92 (2634.62 same meas both - both used to set center. see east.

11-1887 Hunter P 423 No 412 S2 John Griffin found remains of stake in mound. P193.

-16 east. stake, prop corner, M & L 20.08.

-. meas south. 39.84. accepted corner.

over)

11-1907 Chas Armstrong P110B L 1-2-11-12. J Kelly
found rotted stake with flat limestone on top ← unrecorded 7-1903 Book 10 p 16 R Thomas & others.
set 2x3x10 L.S. on S side renewed stake.
– run line from NW 2 over above W¼ 2 and came
To the west of SW 2 which makes W¼ 2 35 lks (23.10)
west of direct line between section corners.
– Meas north 39.37 (2598.42 south 39.84 2629.44
No north south road now.

Corner found and used with pipe riser after road established
9-15-64. found pipe & limestone set C/M over pipe.
Rec PP ESE 41.0 – square Alum disc top on post E 34.05
punched cross in N end metal culv. sub station SSW 91.2
Corner lies at least 3' west of road – 2' north fence east.
– Meas north 2598.1 with rod on line on hill crest just
off west edge road. opposite big power pole 1580 L of NW 2.
see Center 2 & SW 2 for ¼ E & S.

High Forest 1/4 corner 2-3 #540206 (2)
Gail Notes Yoder 1953
40.00 set temp 1/4 set. post
South between sects. 2+3
39.62 set 1/4 set post in mound of earth & soil deposited charcoal made
trench, pits, planted Osage Orange
seeds E-W.


11/25/86 FD CIM (TOP GONE) DOWN ½', S½'W & 2'N OF LINE OF FENCE EAST ½' ½' N OF FENCE WEST

PLASTIC DISC (DRIVEN OVER OLD DISC) IN NE SIDE PP* 9754 SE 41.28

SQ DISC IN TOP OF C.P. ESE 34.54

PLASTIC DISC IN NE SIDE P.P. # 24963 NW 35.63

1/16TH WEST OF 1/4 COR 2-3 HIGH FOREST 105-14
12/12½ 15/86 DUG FROM T.N. AS FOLLOWS

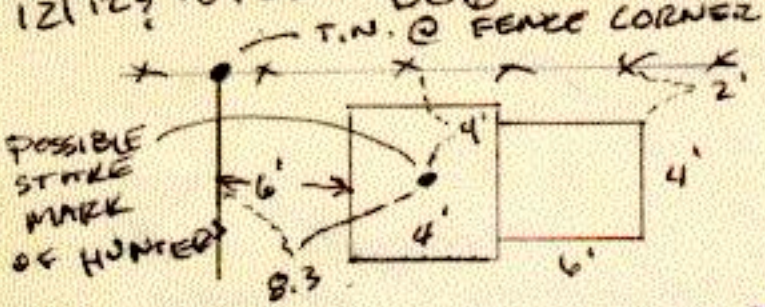

July 24 1903
1/4 2, 3 (page 712, No. 625½) Robert Fraser Found
Stone Mr Higginbad put in place of stone,
which he laid flat, measure C.t Hunters
Chained east 20.08 ~~set~~ stake M.L 20.08
to center of section, Corner post which Mr
Fulton said he put in place of stake, which
was broke off when cutting down a tree.