#5405061

~~6-15-1964 set C/M by line & meas~~
5-2-1980 ~~Note: Corner location possibly wrong~~ Rec 4-28-1980
Reset CIM To stake remains — by pat + Tom

1/4 Corner 5-6 High Forest 105-14

No notes of any kind. existing 2 corners likely both in error some.

6-15-1964 J Kerr for Edwin Dody to divide SW 1/4 section 5 equally. be N 1/2 and S 1/2. (Kerr field Book 89 p. 33-34

- found 3/4" iron driven by McElhie as corner from south. 2622.5 North of iron pipe used as SW corner sec 5.
- set C/M in place of pipe at 5-6-7-8.
- ran line and meas north, set 1/16 pipe at 1319.86. and C/M at 2639.72
- meas 1/4 5-8 as set north to N 1/4 5 5271.2.
- set 1/16 north at 1316.86 or 2633.12 to center 5

(over

Making N½ of N-S ¼ line sec. 5 2637.48 to N¼ 5.
- believe N-S of ¼ 5-6 set by projecting fence line
as occupied at center 5. . to arrive at 2639.72
as Northing of ¼ 5-6 RPS to C/M at ¼ 5-6
- corner. Lies 15.8 north of M'Ghie rod (5/8" iron rod)
36.82 NW to Arrow tooth in 14" burr oak.
30.75 SW to east pipe of iron railing North Culvabutm
43.3 SE to 20 D in 16" burr bak.
steel post set by C/M some ~~50~~ 36' ± west of fence north.
- 7-28 dug extensively at Corner post at Center 6, meac
east - C&M at about 2614± fence N at least 2650±
11-14-72 Aerial from W¼6 over large Ist Post at Center 6 fell 26' S of C/M
Lee 5-6-7-8

#540506 (2)

High. Forest 1/4 corner 5-6
Cart Notes Jr. by 1953
40.00 Set temp 1/4 steel post
South 17' E on true line between 5 + 6
40.30 Set 1/4 steel post
Bur Oak 10 in N 35 W 23 1/5
Bur Oak 12 " N 82 E 110 " } Looked for B.T.'s on 4-28-1980 RWB did not locate any.

4-28-1980 RWB- Visited Corner Site found J. Kerr CIM with steel post on So. Side of CIM, also found Me+B 5/8" rod 15.8' So. of C.I.M.
Walked So. To Kerr's 1/16 Corner location, found 1½" pipe almost out of ground on E side of Cor. p. of fences N-S + E. - Old N-S fence bulkhead and a few old posts and wire through 15" oak Trees indicates old fence was 12'-14' East of Kerr's line (line of newer fence) Also, the old bulkhead and old posts about 200' So. of this 1/4 5-6 location indicates old fence stood about 27' East of newer fence

(over)

4-28-1980 Con't. - did not dig at 1/4 Cor. location as produced by this old fence which came about 26'-28' East of Kerr's CIM. Then went North 660' To an old E-W fence at the So. edge of woods (N. edge of field) found evidence of old wood posts at the 660' Corner and measured South on a line ± 50' E. of N-S fence (rough measured along line by myself) = 660' came about 4' N. of N. road fence of E-W Road. or about 10' South of C.IM. - Possible Corner location could be produced by the old N-S fence from South and 660' So. of that old fence (property split at that 40 Acre line shown in 1875 plat book) and evidently still maintained there although property ownership is all one now.

J. Kerr evidently intended To set his CIM on the line between the Section Corners and possibly by extending from E. 1/4 Cor. sec. 5 over fence location near Center 5 (E. & W. sides Co. Rd 8) This could account for his 1/4 Cor. location To be West of old fence (N-S) line and about 15' N. of N. road fence running East (from 36' E.)

#540506 (3)

¼ Corner 5-6 High Forest

5-1-1980 Co. Surv. - dug at location of old fence line produced from South and at 660'± from old fence post North. Found remains of old wood stake or post appx. 4" dia and going down about 2' from surface. On 5-2-1980 Pat and Tom F. removed Kerr's CIM (left iron below if any) and set same CIM over a ¾"×10" iron rod in stake hole. Monu. about 25' East of Kerr's location and about 12'-14' South

R.Ps - Spike in 18" Burr oak E.S.E. - 15.16'
Spike in 12" Red oak - N.W. - 9.25
East pipe standard of Culvert Abutment - S.W. - 40.48
Corner lies 11' West of fence North.
Corner lies 29.60' S.E.ly of former location
" " 25.23' East of McGhie's rod


10-1-82, 1/4 Cor 5-6 : Found CIM in North road ditch. Set survey marker sign and post .7 North.


High Forest Twp.

Ties to E. ¼ Cor. Sec. 6-105-14

reset CIM by T. Ferguson and Pat

5-2-1980

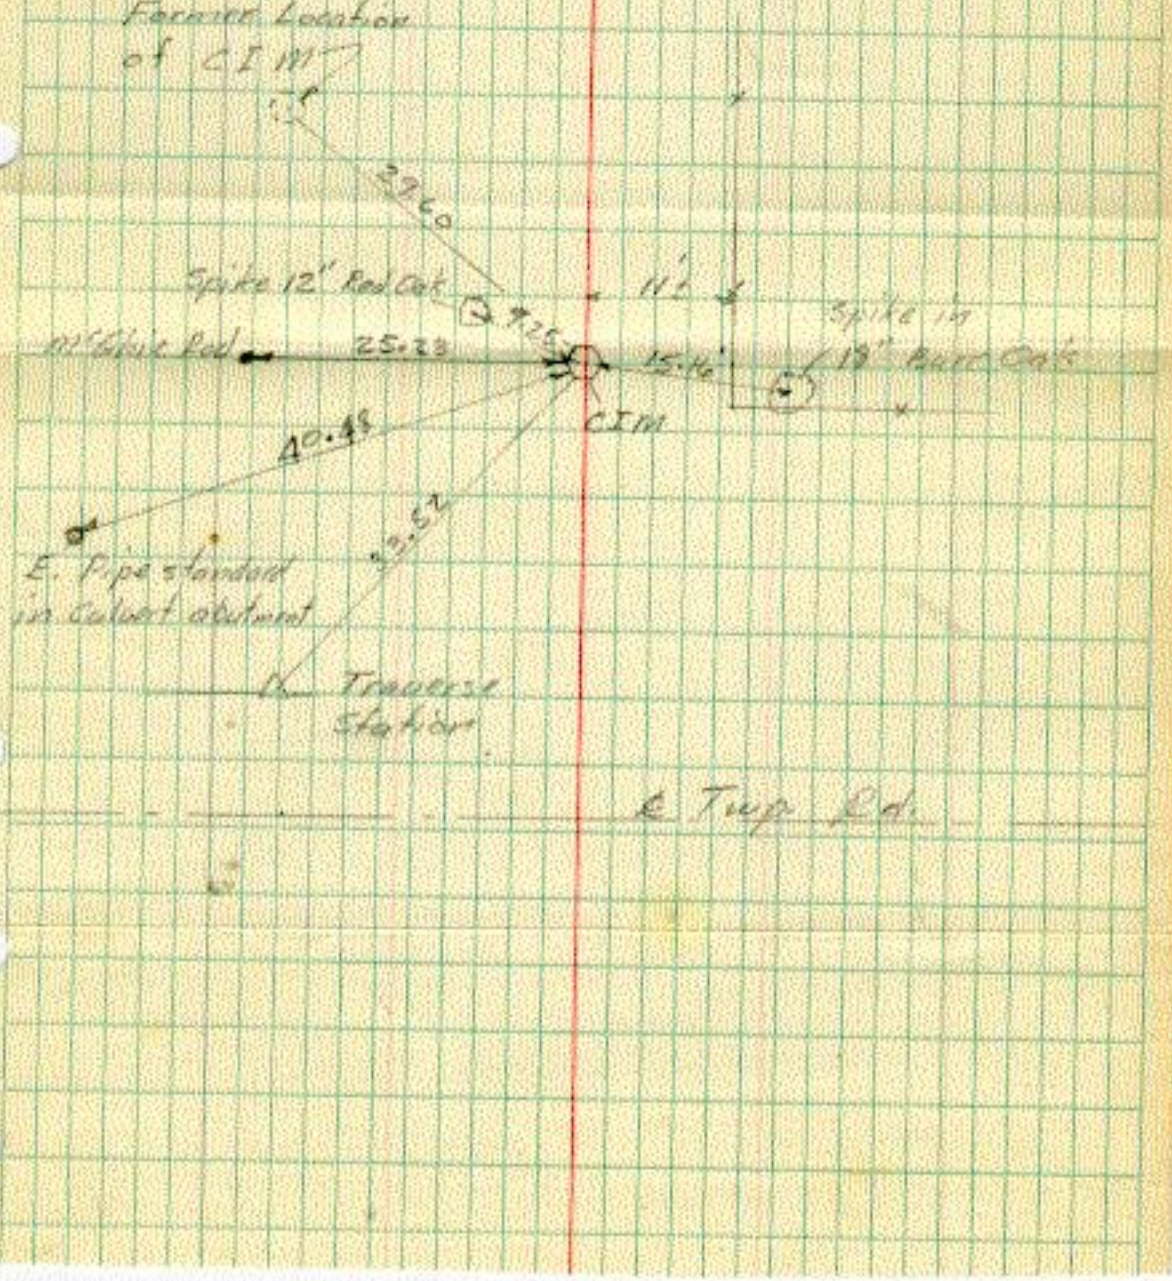

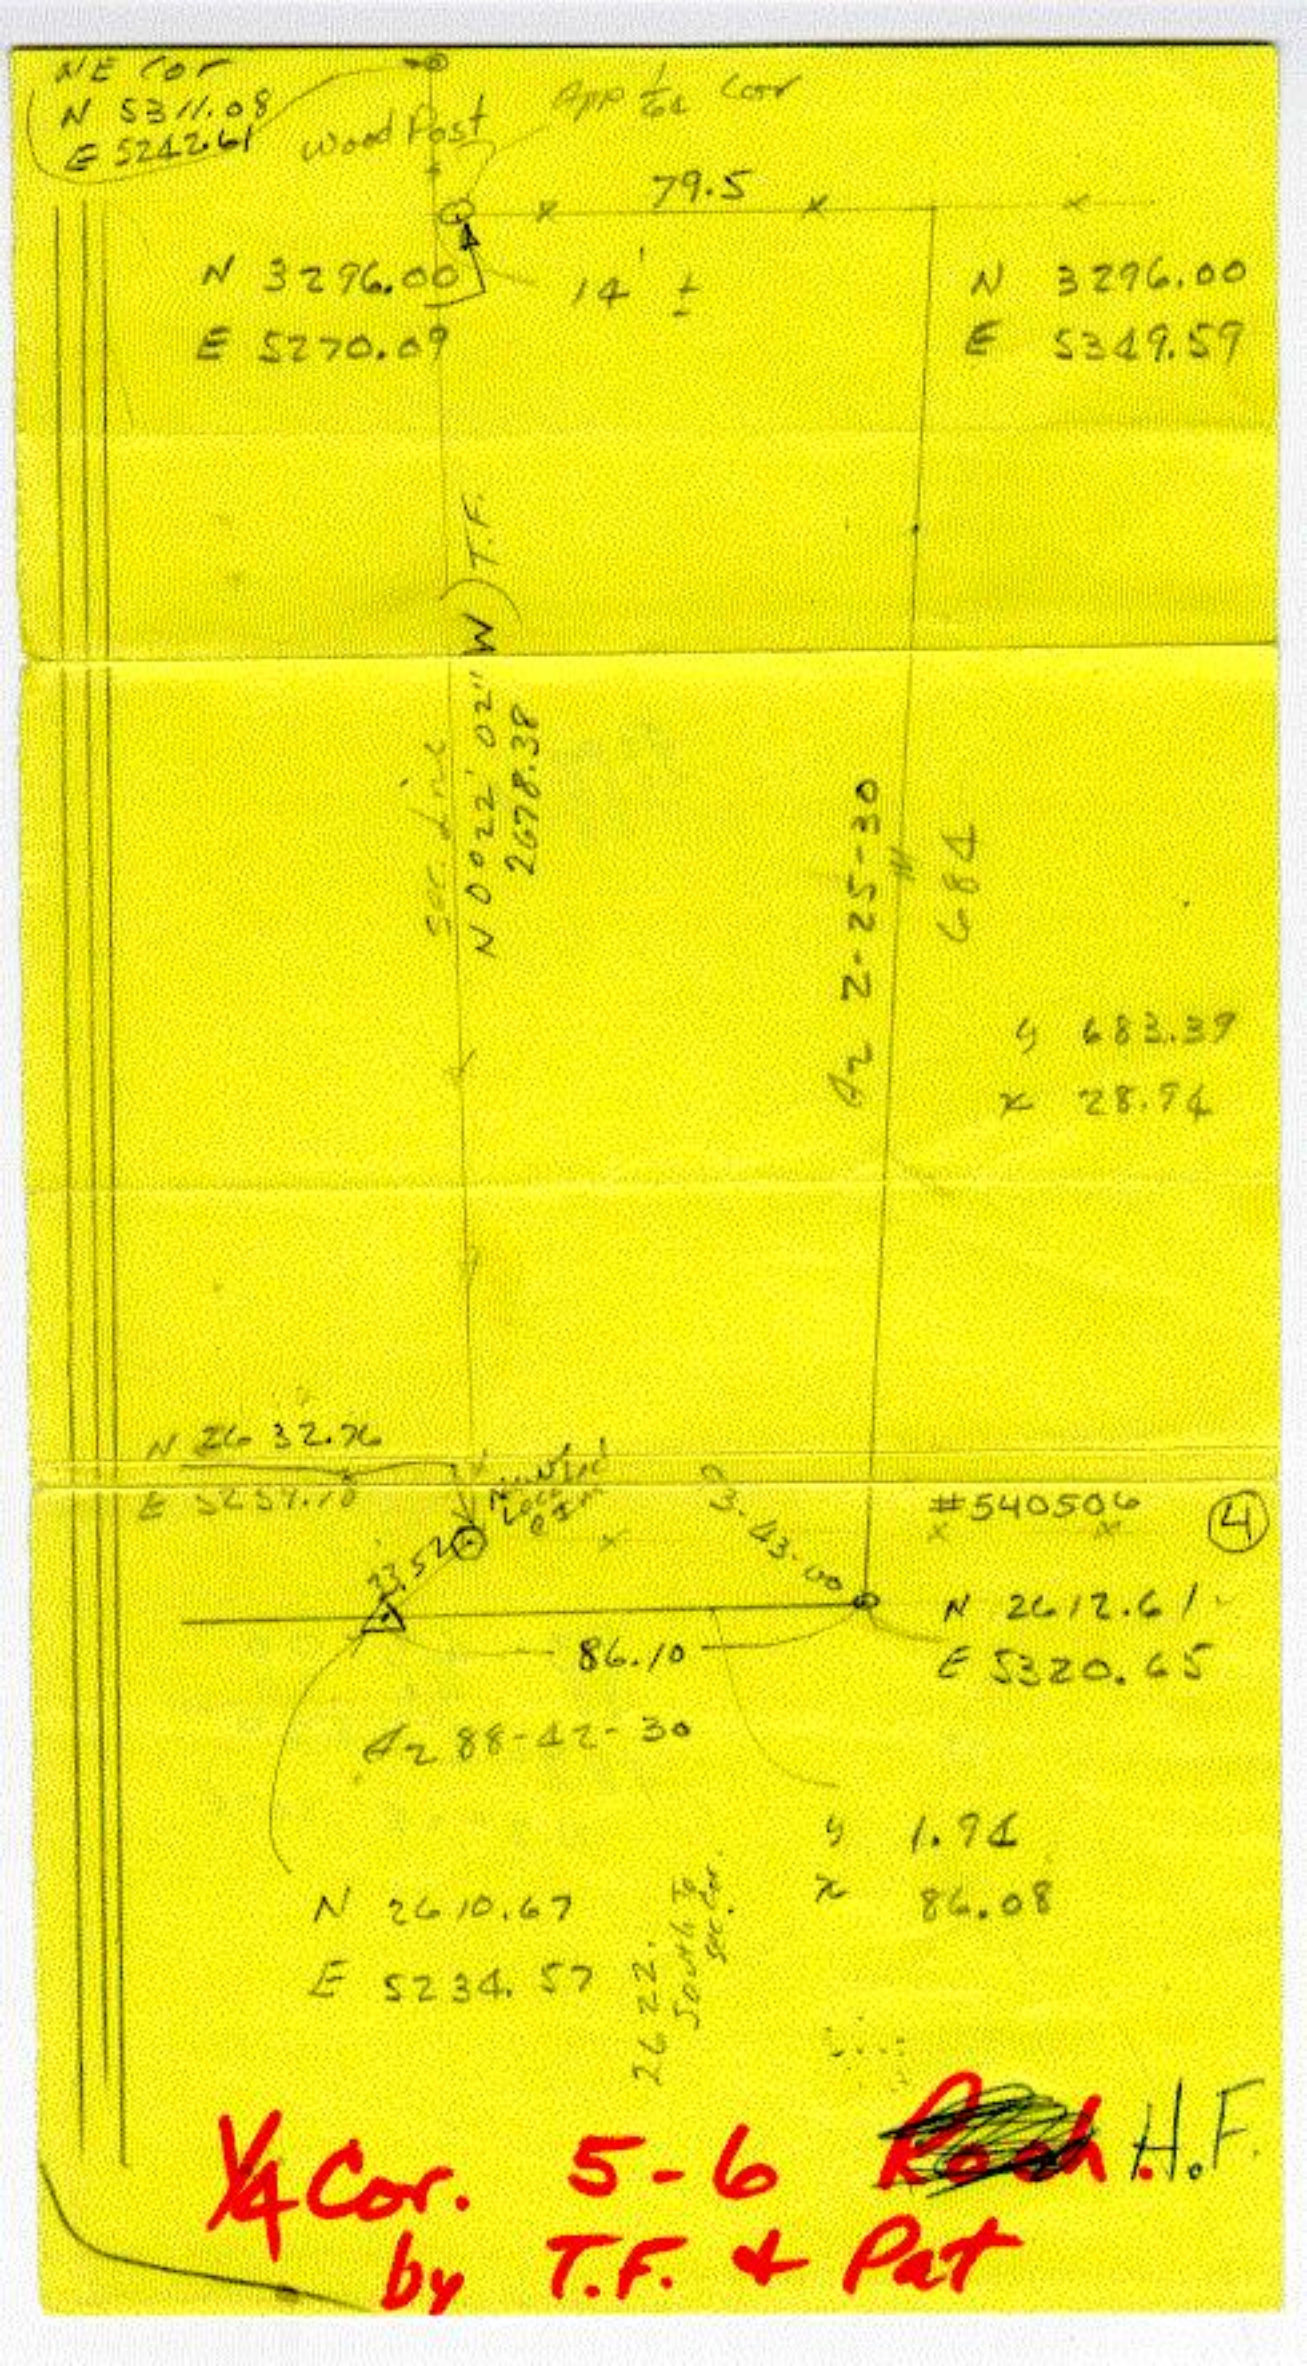

1/4 Cor. 5-6 Rock H.F.
by T.F. & Pat