/ T. E and Pat May 1980 set pipe as 1/4 Cor on line between Sec. Corners and Gov't prorated ~~meas~~ (not T. H. meas) falls ± 3' N. ely of ft

1/4 Corner 11-2-82 C-2C 6-7 High Forest 105-14 #540604 (1)

4-1872 Hunter P194 No 205 S. Dennison, Allen & P Sullivan, etal

found small unmarked stake standing,

B trees cut but stumps standing with marks still plain.

- set new stake, marked with 2 witness trees.

1- 8" bur oak N 37° W 29 lks. 19.14. 11.52 W of line

2- 15" B oak S 32° W 115 lks 75.9 40.22 W of line S.

-16 E "1" set stake M & L 19.88 (1312.08' with 2 witness trees

1- 4" br oak. S 37¼ E 102 lks. 67.32' on line to stake in mound

2- 4" br oak. S 89½ W 69 lks. 45.54

-16 W. "2" set point on line to long. stone found as corner.

govt meas 39.46 2604.36 act 39.21 2587.86

(over

16 W cont- set corner at 19.87 (1311.75
then 19.34 (1276.44' to long slope as corner.
16 Center NW 1/4 47. "4" set this corner on N-S 1/16 line entire mile.
intersecting line from "13" to "3" the E-W 1/16 line entire mile.
Meas. west to 1/16 on town line 19.35 (1277.10
16 S. "5" set stake on direct E-W 1/16 line
39.12. 2581. west to 1/16. on town line
Brs to "2" 1/16 W. 16" brak. S 8° E 70 lks 46.2
12" brak. N 8° W 79 " 52.14
Gen'l Notes Surveyed 1853
40.00 Set temp 1/4 sect. post
Course N 89° 30' East on town line between sect 6 & 7
39.96 Set = 1/4 Sect post
Bur Oak 10 in N 40 E 66 lks
Bur Oak 12 in S 61 E 69 lks


#540604 (2)

¼ Corner 6-7 High Forest 105-14

May, 1980
T.F. and Pat, set iron pipe as ¼ Cor. by Triangulation and Trav. measuring on line between Sec. Corners and at Gov't prorated Meas. (They did not use T.H. 1872 meas. although the difference would be only a few tenths of a foot. also set 1/16 Corner East. which fell near a fence Corner. Used this ¼ Corner location To set Center Sec. 6 and 1/16 South of Center Sec 6. ~~Cent~~. Center 6 set iron pipe, 1/16 So. set Long spike near ~~Oak~~ bottom.

11-2-82, ¼ Cor 6-7: Dug from T. Ferguson pipe 4' South to fence and South 3' further. Dug for 3' East and 3' West. Dug down only 1'. Found nothing - Just even a post mark. Set a CIC/P² as the corner on line from W. 6-7 over the stake mark found at the 1/16 East and at Hunter prorated measure from W. 6-7 to Sec. Cor. 5-6-78. This ~~also~~ also placed the corner appx 5½ lks South of a

straight line between the section corners as determined from Hunter's survey No. 205. Corner 1.2 East of steel fence post, corner post to fence N-S-E. We did not double the measure of the 1/16W since this would have placed the corner 2' farther East or 3' East of the fence South.

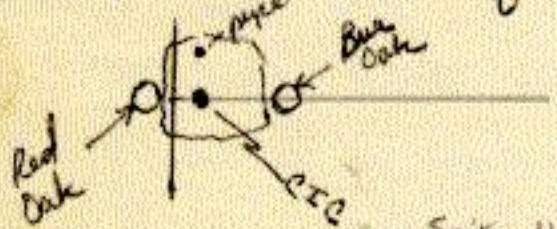

RP's: Spike and CSD in East side
16" Cherry tree NE 20.10
Spike (OLD) in NE side 14"
Red Oak NW 27.21
Spike N. Side huge Red Oak W. 5.80

Should be South 3.0 ft of Ferguson

Set survey marker sign and post .6 West

11-2-82, 1/16 South: Dug from a point 4' ~~East~~ West of the C.P. to fence N and West. West 5' and North 3½' by 2½ deep to clay. We did not find anything. Older fence North is 6' to 8' West of the newer fence corner here which we shot.