
1-14-1972 set CIM ore, short rod MBL 2642.62

1/4 Corner west 1/4 6 Hi Forest 105-14 #540606
east 1/4 1 Rock Dell 105-15

3-9-1900 R Fraser P652 No 582½ L6 Hi Forest Rock Dell Town Board found boulder stone with point up declared by Mr Lars Rasmussen to be location of true corner. laid out road between these two townships

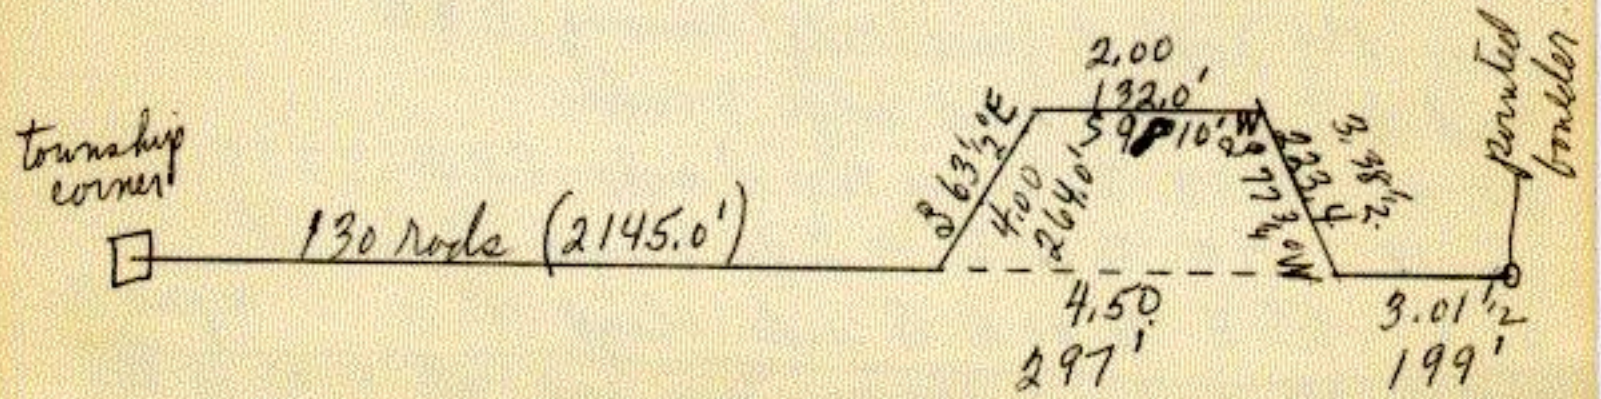

11-10-92- searched and re searched for this corner since 1969.
found orig 1872 limestone at 2 ft 6-7. 105-14.
Meas line elec between it and township corner. N W 6.
5285.24 Set C I M over chat rod N 0 L 2642.62.
record north 2641.62 no meas ever south.
dug, probed and searched for stone mentioned by R Fraser 1900.
found boulders all over area 18" and deeper none upt pointed.
Corner 5'± north of fence ridge running E & W.
and 6'± west of west edge woods.
30.55 W S W to 7 inch Cap & side P P ± 9235.
13.14 N E to 60 Ø N side blazed 16" hardwood.
21.3 E S E to 60 Ø S side blazed 10" " " infront E.
10/19/78 Set a Survey Marker Sign and Post 1' N. of the CIM