
10-12-82 CJC

#541706

1/4 corner 17-18 Ft Forest 10S-14E
5-1874 Hunter P245 No 246 d18 C Kittleson, C Mickleson
found corner post & fence running all 4 ways in what
appeared to be mound - post claimed set in center of
mound. took corner post as corner.
no mear or 1/16 corners in any direction.
Gov't Notes 4-6 by 1853
40.00 set a 1/4 sect. post in mound of
earth & sod. depressed charcoal. made
trench & pits - planted Osage Orange
seed E+W

10-12-82, 1/4 Cor. 17-18: Dug around the corner post to
fence N-S-E-W as follows:
by 2' to 2½' to bdrock.

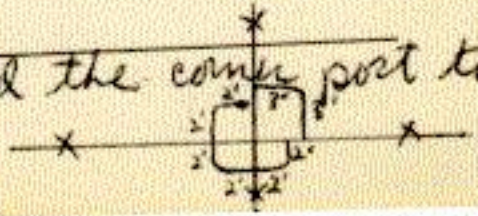

We did not even find the mark of an old post, so assumed any evidence had been destroyed in setting large new corner post. Accepted fence corner as corner and set a CIC/p² on the corner on the West side of the c.p. (Corner .87 W. and 1.23 N. of the t.n.)

RP's:

Spike in E side gate post S. 17.94

Spike in N side gate post W 26.69

CSD in c.p. ENE .89