1 6-1968 iron set by J Kerr on line and prop meas OK. (1)

¼ corner 19 - 20 Hi Forest 105-14 #54206

5-1870 Perry by Hunter P177 no 188 S20 C Wilson J Rogers found stake not marked in slight mound said to be orig location of corner in line fence east

- meas north to stake standing 40.15 (2649.90
- meas south to 16 cor stake set M & L 20.21 - 1333.86
  or 2667.72 or 5317.62 for mile.
- meas east 39.87 (~~1311.02~~ 2631.42

10-1888 Hunter P425 no 414 S19-30 R Sage, H. Hulbert

Corner gone - road plowed & graded up. found several posts of fence running east - set stake (temp) on line in line posts east

16 north set stone & stake M & L 20.15½ or 2660.46

-16 south set stake M & L 20.24 or 2671.68

5332.14

This proportion not same as P177.


6-1968 J Kerr found orig stone ΔE19. - no sense in digging for 1/4 19-20 Deep fill - wet lands - no perm corner. Meas from stone north .1339 to 1/16 fence east R 1331.86 & 1335.84 1870 1888.
set random rod. Halfway between center & W edge road.
Comes 5'± south of crooked fence east.
42.7 east to N-S road fence - 42.0 west to N-S road fence.
- Meas south to stone 2668.7 record 2663.72 1870 2671.68 1888.
- Meas north to rod set as sec cor 2657.66 1870 5317.62
record. 1870 - 2649.90 1888 - 2660.46 1888 5326.36
direct line comes off road on west side near 1/16 cor south, then at 1/4 corner comes very near where random rod set that at 1/16 north comes near center or couple feet west hitting center road at north end - a real screwed up line.
- at 1/16 north dug extensively over 4' deep 5' square or more. soil mixed all over below corner couldn't survive likely

1968 5326.36
1973 5326.54

Card #2. 1/4 19-20 High Forest 105-14. (2)

#542006

10-25-73 dug for 1/16 south from line of fence east 1339' from C 1/4 south at 19-20-29-30 at least 8' south 3 or 4 feet each side line ran 1968. found vertical (nearly) boulder. 6 x 8 x 20. with dark soil in clay where stone was dug in. stone in close line to fence east and 3' from west edge road top. - stone out of station but in near 1968 line.

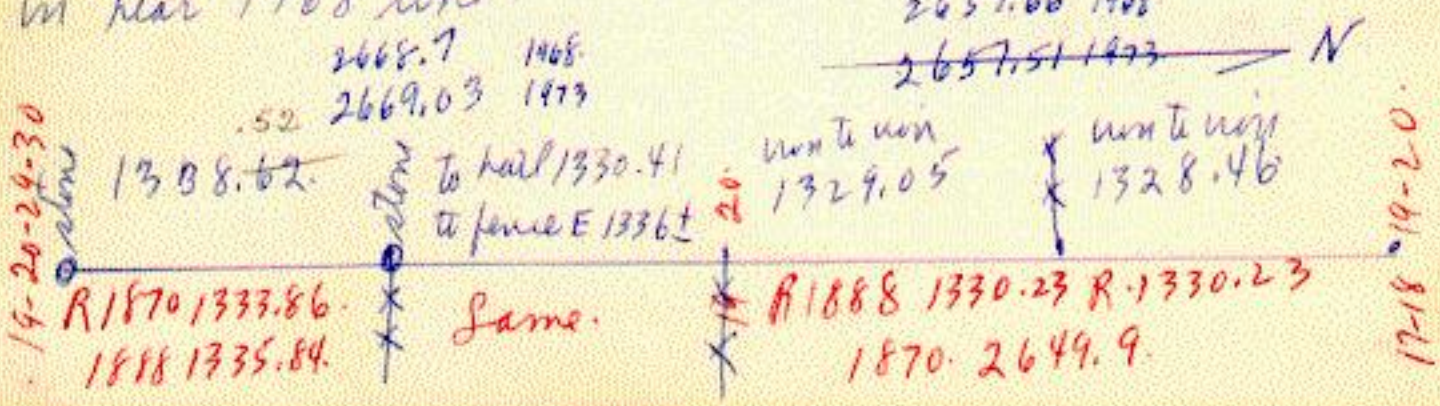


RP Line. 39.8 E to L iron edge N side corner post.
54.0 SE to cone nail SW side tele pole up 4'
10-26-73 dug with backhoe from. about station 2670
to 2680 or 4' North of fence east 3' or either side of line
from C/M at 19-20-29-30 over 1/16 stone found. in line
of fence running east, very much over record. 1338.62
R. 1870 1333.86 - 1888 1335.84
5/8 Rebar iron corner until proven otherwise.

2671.6'
2664.62
3-

1973 line between 19 and 20 High Forest 105-14. (3)

This card with 1/4 19-20 High Forest 105-14. #542006

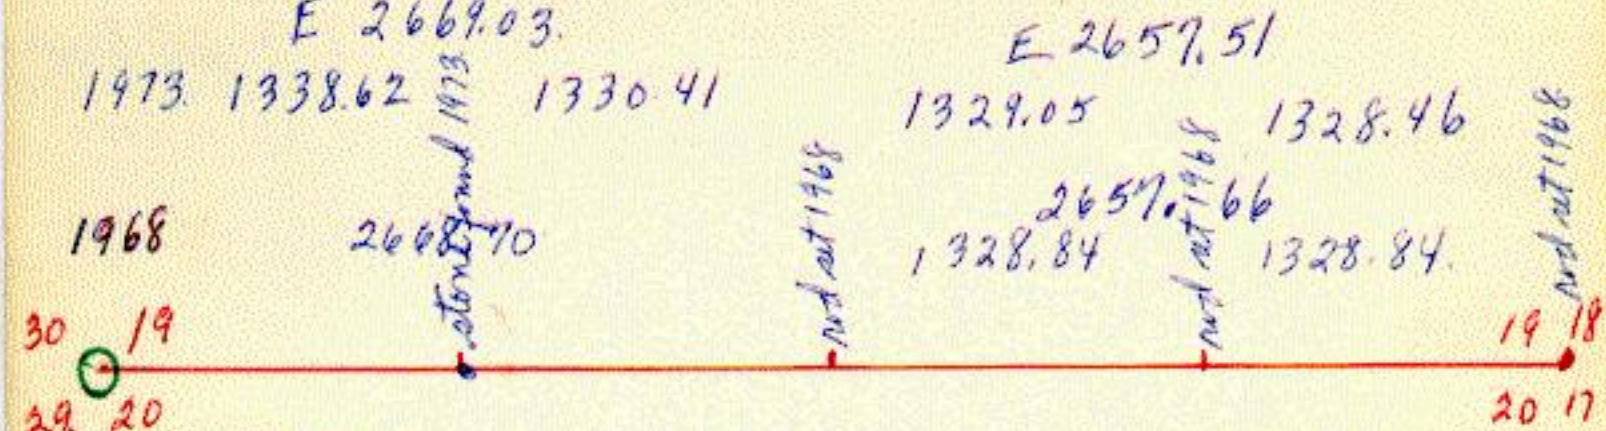

1870 1333.86 1333.86

2667.72

2649.90

1888 1335.84 1335.84

1330.23 1330.23

2671.68

2660.46 (over line)

Note line from W 1/4 19 over 1/16 corner east fell near enough readable on iron set by State.

electronic line from C/M at 19-20-29-30 over
1/16 stone north projected north.
found 1/4 19-20 rod set by J Kerr 1.6 E of proj line
found 1/16 rod set by J Kerr north 1.8 E of " "
found 19-18-19-20 rod set by J Kerr 2.58 E of " ".
Rod at 1/4 19-20 replaced as found.
Gen. Notes T. by 1953
40.00 set a 1/4 steel post in mound of earth & rock from pits planted Orange Orange steel E & W

10-1-82, 1/4 Cor 19-20: Found a 1/2" re-rod 5 1/2' South of C.P. to fence West (fence now gone) on West side of road. Iron 4' West of ℄ crushed rock road.

#542006 (4)

1/4 Corner 19-20, High Forest, 105-14

10-1-82, 1/16 South: Found ½" rod 8' West ℄ N-S crushed rock road and appx 1' South of line of slightly crooked fence East. Rod bent over but bottom straight. Replaced bent rod with ¾" rod. Felt like we hit stone when we drove it down. Believe iron on stone found 10-25-73. 11-16-82 Pulled iron on stone after setting 1/4 Cor 19-20

10-1-82, 1/16 North: Found ½" rod bent over 1' West of ℄ N-S crushed rock road and slightly South of fences East and West. Replaced bent rod with new ½" rod. 11-8-82, Removed rod after setting 1/4 Cor 19-20 & Sec Cor 17-18-19-20

10-21-82, 1/4 Cor 19-20: Dug from ½" rod (removed) 5' East, 5' West, 3' North, 4' South by 3½' to 4' deep to clay. Area had not been dug before. Fair condition with good black dirt on West ½ of hole but did not find anything. rod & spikes S. 45° W and 7.38' E ½" rod 3.2' W & 4.2' E (gone)

11-8-82, 1/4 Cor 19-20: Set a CIM over a 12-rod on the corner on the line from the SE Cor 19 to the NE Cor 19 (as set this survey) and on the line from the W 1/4 Cor 19 over the 1/16 East. Corner .25 N. and 1.66 E. of the former rod location.

RPs: Punch hole in top So. end C.M.P. in field drive WNW 27.27

Punch hole in top N. end CMP in field drive NW 34.04

2 1/2' W & E

CSD (up 4") in corner post WNW 43.99

Corner 3' West & and 5' South old fence (gone)