6-11-1968 set C/M. over orig stone with 1"x2' pipe on east side stone as true corner. (1) #542106
Note: 8-8-1978 found Top of C/M broken off
1/4 corner. 20-21 Ft Forest 105-14.
5-18 To Perry by Hunter P177 No 188 & 20 C. Willson, J. Rogers.
found stake standing
- Meas south 40.16 (2650.56' N 1/2° E.
- Meas west 39.64 (2616.24' S 89° 20' E.

4-1896 Ft Fraser P594 No 540 & 21 R. Bellamy & others
Corner considered lost - set stone 3x6x22 M & L.
To 0.25 mile overran 50 links.
-16 north set stake M & L 20.12 1/2
-16 south set stone 3x4x16 M & L 20.12 1/2. 1328.25
-16 east set stone M & L 19.91 3/4 (1314.55'
-16 center SW 1/4 21 set stone & iron stake intersection

1960 DuVal. Minn Hwy Dept. found stone set monuses.

6-1968 J Kerr. found stone set C I M with 1"x2' pipe on each side stone as true corner.

N H O dec	fence post	NE	34.8
"	" "	NW	24.8
"	" "	S W	35.7
"	power pole # 11458		22.0

on NW side pole. slightly west of south corner lies center road about 1' west of fence line south. - meas last to center 21 set miles lines 2631.35 record - 2629.1

Good Notes Yr by 1953


40.00 set 0 4" soil post in ground 4 ft rocks sod. disposal channel made trench + posts placed Orig Orig soil

Fall. 1982: Found and shot CIM. See DRWG 5-17

#542106 (2)

1/4 Cor 20-21, High Forest, 105-14

10-26-82, 1/4 Cor 20-21: Dug from a point 8' West and 2' South of the CIM in place as follows:

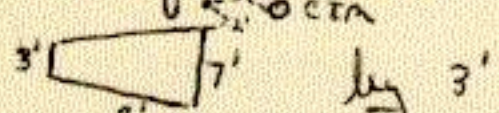

by 3' deep to clay.

Good black dirt but found nothing. Digging to cover Hunter's measure from Sec. Cor. 20-21-28-29 and Hunter's measure from the N-S 1/4 line Sec. 20 figuring the N 1/4 Cor 20 to be 14' to 20' West of the PIC (over Mn/Dot Cone Mon) shot there. Had trouble with water in bottom of hole.

(wanted to look 11½' to 16' West and 5' South ?)