1 9-10-71 set 1½" x 54" iron pipe in stake remains hole.
#542305 (1)
section corner 22-23-26-27 High Forest 105-14
6-1899 H Fraser P 659 no 587 L 26 Iron Board
corner in washout and gone for many years.
relocated corner by Midway N & L 40.04 (2642.64'
and meas east 40.15½ 2650.25' to stake set N & L.
and meas west 40.18 2651.88 to stone set midway
on N line Sec 27 and in line fence running west.
no desc of corner assumed to be a wood stake
witness trees to corner set.
10" burr oak south 153 links (100.98'
10" burr oak S 26½° W 149¼ lks. (98.5'
over

12-1910 Chas Larson. P146 B & 27. John Fitzpatrick found oak stake set by H Frasey.
- meas west to center R/W of railroad. 192'
- set stake "6" 660' south which came 3.5' E center railroad.
- set stake "7" 1320' south of above stake or 1980' south of oak stake found. which came 180' east of Cente RR.
- set iron stake on 1/16 line running "14" west into NE 1/4 27. either on west railroad RW or 50' west of W railroad RW.
poor survey. other figures on survey.

4-31-1906 Chas Armstrong P108 B. NW 1/4 26. Judge Probate court.
Claimed stones found at all 4 corners of NW 1/4 26.
set stones on west line NW 1/4 26 apparently at 1/64 and 1/16 corners north of stone found at 1/4 26-27. No meas given
See Card 2.

#542305

Card #2. 22-23-26-27 High forest 105-14. (2)

Ch armstrong cont. shows same 2 witness trees at NW 26. 10" brk S 156 lbs 102.96 WF 100.98

10" br oak S 26½° W 149 links. 98.34 WF 98.34


one assumes all corners on direct line as W Fraser never set any corners on this line.

9-10-71. set ¼ 26-27 (full length steel fence post driven down to 4" below road surface) on line from ¼ 25-26 stone over stone at center 26. and recorded meas west minus same shortage as east ½ of ¼ line.

– Meas north from corner, found ~~undisputed~~ limestone in open pasture lands at 666.9, established true line and projected line north to P I or P.O.T at 1200.0, cont line and meas to stone lying flat $\frac{4}{6} \times \frac{4}{8} \times 16$ at 1325.55. which if erected with bg end down would come only .75' west of line as run so far. left stone as is.

(over

Cont line and meas north on traverse line as follows.

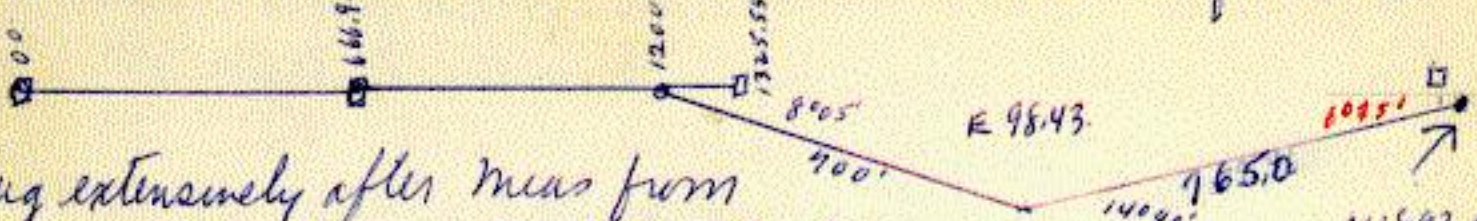

dug extensively after meas from
2 bearing trees and railroad (trees and railroad very slop & rough (not accepted). - found definate soft, discolored spot in soil which coned have been years ago a wood stake. no sign of any stone at all this mark within 6.5' of wld & raised RPs to tree. drove 1½" x 4½' rusty iron pipe in hole in soil which came 4.32 W. 10.3 S of end of traverse or 2642.7. R. W^m F 2642.64 and 6.4 E of direct line. indicating ¼ 26-27 coned be OK N & S but further west 2' Corner like 3' W of N-S fence.

N 693.04
+ 1200
1893.04

14.7 55 W of corner post of fence N & E.

#542305 (3)

Section Corner 22-23-26-27 High Front 105-14

3-23-81 (1981 Remon) Found 2" pipe packed in rock and ground still frozen. Drove pipe down to within 4" of ground and set a survey marker sign and post .45 North. This corner 3' West of N-S fence and in line with the fence East. Creek runs just West of the corner.

High Point Section corner 22-23-26-27
Gen'l Notes Surv 1853 #542305 (4)
80.00 Set-post-cor to Sect 22-23-26-27
Br. Oak 10 in N 68 W 3.38 lks
Br. Oak 12 in S 52 E 2.07 lks
Br. Oak 12 in S 60 W 3.42 lks
Mode Intech