
#550406 (1)

¼ corner 4-5 Rock Dell 105-15

No records.
11-1935 Co H D B 99 P 18 iron stake as corner or pipe.

Dr. spike in pine NW 86.7

1966 Co H D B 303 P 40 found ¾ x 1¼ x 3' iron shaft.
painted spike & Disc PP west 76.02
top of 2nd steel FP southwest 66.57
South from X Feet
PI Sta 495+91.52 also tie to corner.
Corner may be in ditch

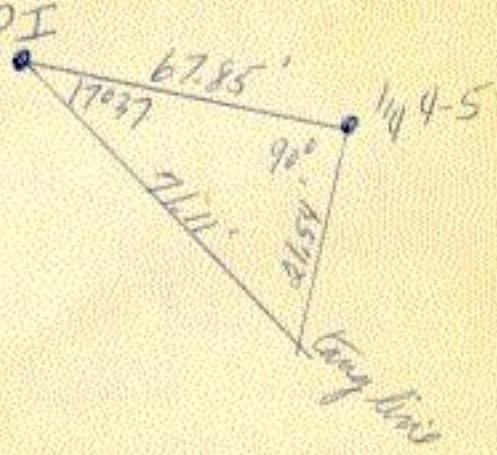

Set by Michael Kerrick 5-1854
2.25 Creek 6 lks wide runs NE
20.20 Stream 35 lks wide runs East
55 E on true line
40.15 set quarter section post
{ Burr Oak 10 S 25 W 4 16
White Oak 15 S 10 E 763
274.56

6-23-1980 (1980 Remon. BK., Page 70) 1/4 Cor 4-5: Dug and found bolster pin (7/8" x 10" pipe with RR spike in head) 2.2 deep standing in an old road but still well up in fill. This pin is in line with fence West and and 7' N & and 33.1 West and approx .6 South of a 3/4" x 1 1/4" topped iron we shot in the East ditch. Removed pin. Dug 1' West, 6' East, 4' North, and 4' South. Natural soil was 5' deep on West side of the hole and 3 1/2' deep on East side of the hole. Pin { West 3.66 North 7.07 East 18.00

¼ Corner 4-5 Rock Dell 105-15 (2)

#550406

6-25-1980 (1980 Lemon Bk.) ¼ Cor 4-5: Dug from East edge previous diggings East for 6 more feet. Natural soil 3½' deep. Dug 5' deep to clay. Found nothing.