See Dwg 23 For coord ①

#550506

1/4 Corner 5-6 Rock Dell 105-15

Set by Michael Karrick 5-1854

39.85 so. Set quarter section post

Black Oak 10 S 50 E 635

Dug Trench.

50.80 no. Stream 35 lks wide runs east.

8-1984, 1/4 Cor. 5-6 : dug from the traverse nail (set in the ℄ N-S Road and in line with fences E & W) for 4' North, 6' South, 10' West and 10' East. Found the possible remains of a stake in the area 9½' East of the t.n. (two wood piece about 4"


long and 2" diameter) but could not find a hole where it could have stood. Someone had dug in the center of the road from the line of the fence, South for 7' by appx 3' wide. We were digging 3½'± deep here. The oldest road was covered with sand and there was 6" to 1' of dirt beneath it. The diggings found was beneath the road We also dug across the road from 13' to 23' South of the t.n. to cover prorated location as per Will Fraser's survey but did not find anything further → (PST 9 No 529, BK A)

Although W. Fraser does not mention the fence, it is an old property line and was doubtless there when he surveyed Therefore we will hold the N-S loc. of t.n. when cor. set.

#550506 (2)

1/4 Cor 5-6, Rock Dell, 105-15

8-1984 continued: Dig was as follows:

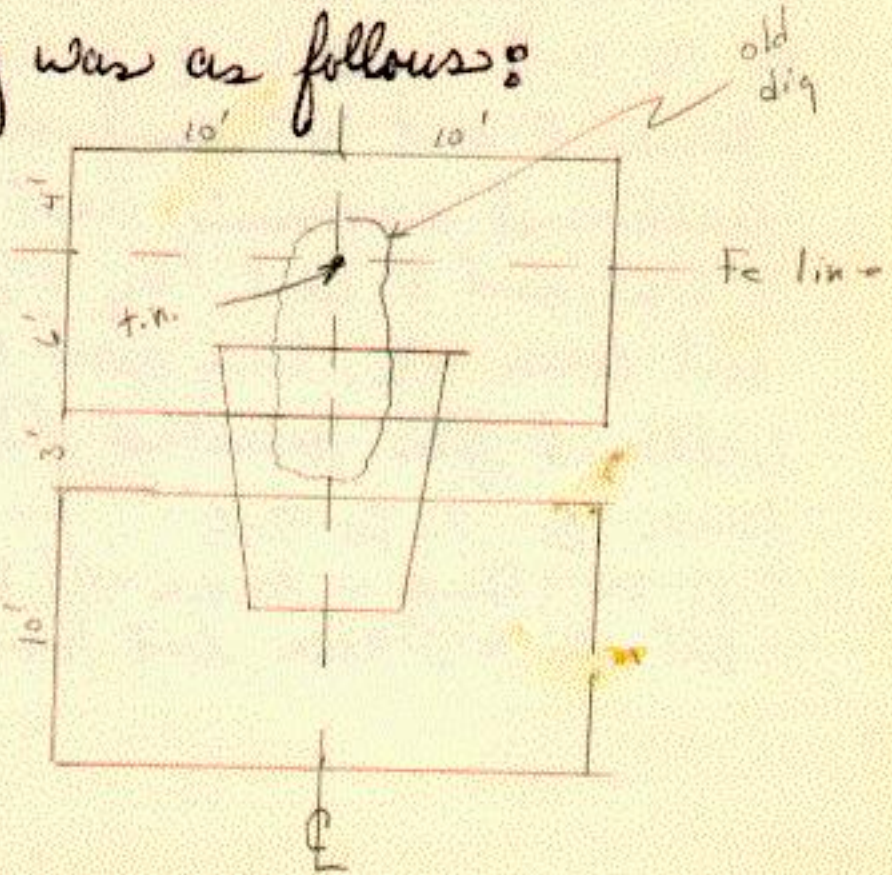

8-10-84, 1/16 North of 1/4 Cor. 5-6 : Dug from a point on line from the CIM @ No. 5-6 to the t.n. @ 1/4 5-6 (nail in ℄ N-S road and in line fences E and W) and in line with old fence bulkhead running East for 4' North, 6' South, 5' West, and 3' East by 5½' deep to clay. Black dirt down 4½'. Very good condition and bulkhead fits prorated. Don't measure to fence @ 1/4 Cor 5-6

8-13-84 : Dug 5' more off E edge of hole. Black dirt to 6½' here but no corner.