57-1965 set CIM from orig survey (assumed cor) (1)

section corner west 6-7 Rock Dell 105-15

#550605

no records.

1939 Co H D. B99. P corner accepted

Lp in FP SE 20.1 Lp in FP SW 18.3.

Meas ~~East~~ West to PI (~~Sta~~ 58+81.4) 459.5

road curves ~~south~~ north of corner, corner could be clear of actual road.

Co H D B266 found ties B99. set CIM from them

1965 ties to CIM.

Lp D in FP NNE 43.07


" " NW 59.65

" " SW 29.80

Michael Kerrick 5-1854
West on Random between 6 & 7
54.55 Creek 30 lks wide runs NE
62.00 Same runs SE
68.40 " " NE
74.65 " " SE
76.64 " " NE
79.68 Intersect range line 17 lks North of Post.

John Ball 10-1853
North between 7 & 12
54.90 Brook 10 links wide runs NE.
80.00 Set post and drove charred stake corner to Sect. 1, 6, 7 and 12. Built mound with trench per instructions. Planted S.E. Osage Orange N.E. Apple seed.

8-24-84, W.6-7: Dug from CHD CIM (removed), in line with ℄ road running West and in line fence running South, as follows:
There is a slough at the South edge of the old road and at that end of the hole the sand was @ 4½' deep. At the North end of the hole

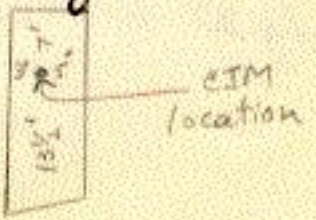

#550605 (2)

West Sec. Cor. 6-7, Rock Dell, 105-15

8-24-84 continued: there was sand @ 2' deep. There was appx 1' of fill over what appears to be the original soil - black dirt containing many pebbles from 1' thick at the North end to 3' at the south end of the hole. The CHD CIM was not set on any iron and they had done no digging. did not find anything. We measured 161' East from the CIM to the top of the creek bank but since the creek runs ENE here an accurate measure to the center could not be taken.

CIM { NW 12.87 / SW 12.98 } 1"x2" nails by rock

8-29-84, W.6-7 : Corner destroyed by cat building new drainage detch. Cat still working so did not try to replace.