6/4/85 set C.I.M. over 3/4" pipe ①

#550705

Section Corner West 7-18 Rock Dell 105-15

John Ball 10-1853

80.00 Set post corner to sect. 7, 12, 13 and 18

Burr Oak 20 N 43°W 223 links

Burr Oak 15 N 31½°E 163 "


No other tree near

Dug trench per instruction.

9-11-84, W. 7-18: Dug from t.n. (set in ℄ rd & in line fences N & S) ~~dug for tree~~ for 5½' South, 3½' East, and 5' West by 4' deep to clay. Conditions very poor on South side of road. Opened hole to dig North side of

road and hit telephone cable but did not break it. Dug on SE'ly side of cable and hit 10"x 10"x10" boulder down 2.4 beneath an old road. Removed boulder and found 4½" diameter hole filled with wood piece. Followed down 2½'+ to tapered point well down into clay (clay down 4'). Someone had dug around the stake well into clay, but had not dug clear to the end of the stake. Drove 1" sq pipe in stake location (top down 4.8') and set boulder on E. side of pipe. Corner .08 South and 1.95 W. of the t.n. (removed). Left nail at road surface over pipe.

t.n. { SE 9.64 / SW 9.79 } stake { SE 10.71 / SW 8.80 }

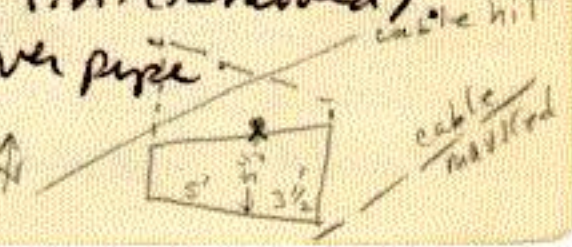

#550705 (2)

West Section Corner 7-18 Rock Dell 105-15

6-14-85, W. 7-18: Set 20" CIM on 3/4" light pipe as the corner (from local RP's still in place) at location of stake and stone found in 1984. Corner in center of E-W road and 2' West of fence N & S.

RP's: CSD in SE side post stub by telephone box NE 37.08

CSD in NE side pp # 6542 SE 105.49