SEE DRW 23 FOR COORD. NEEDS MON (1)

#550806

1/4 Corner 7-8 Rock Dell 105-15


Set by Michael Karrick

40.00 Set quarter section post Burr Oak 8 S75W 224

Black Oak 13 N43E 575

9-13-84, 1/4 Cor 7-8: Dug from traverse nail set in ℄ N-S road and in line with fence running East (this fence not on 1937 aerial and farmer says fence put in by guess - could be projection of fence latter East), for 7½' West and 10' South. Old road with sand surface down 2½', then 6" to 1' of hard packed dirt (either driven or original soil or a black dirt fill) then 1' to 1½'

of black dirt to clay. Found one boulder 5"x5"x12" (leaning 45° North) with base half into black layer. This was the only boulder (among many) that was not a subsoiler or was not above the sand road. It had an unusual shape with ridges spiraling around it. However, there was no stake with it and impossible to tell if it is dug in, in such black soil. It stood 1.85 West and 7.25 South of the t.n. It should be given consideration if another corner found N. or S. to prove it.
ck 15 & 16-84 Continued digging as follows:

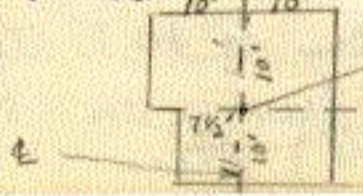

#550806 (2)

1/4 Cor 7-8, Rock Bell, 105-15

9-15 & 16 continued: Did not find any other stones that could be a corner. Found no old post holes nor stakes. The area we were covering here was the prorated location from Sec. Cr 17-18-19-20 to N 5-6 which came 5½ ~~North~~ South of the t.n. (on W. Fraser survey) and also to cover the prorated location from Sec Cr 17-18-19-20 to the E-W fence @ 1/4 Cr 5-6 which came 5' North of the t.n.

t.n. } SE 8.62
     } NE 9.94

stone } NE 16.9
      } E 8.4