#550909

/

¼ corner Center 9 Rock Dell 105-15

6-1875 Hunter P 280 no 277 L9 Peter Hogeboom
& Alexander, etal.


set stake at true miles lines from ¼ corners.

- 1/16 east set stake M & L 19.98½.
- 1/16 north " " " 19.95½.
- 1/16 center NE¼ set M & L 19.97 on N-S 1/16 line.
- 1/16 west set stake " ~~19.99~~ 19.98

also set 1/64 stake betw N ¼ 9 and 1/16 south M & L 9.97¾.

(common land south of corner to ¼ cor on S line)

9-26-84, Center 9: Dug for T. Hunter's stake at Center 9. Dug from a point 1½' north of the t.n. For 3½' West, 2½' East, and 6½' N a chokecherry tree on the West side of the C.P. kept us from digging there. Old C.P. stub on N. side present C.P.

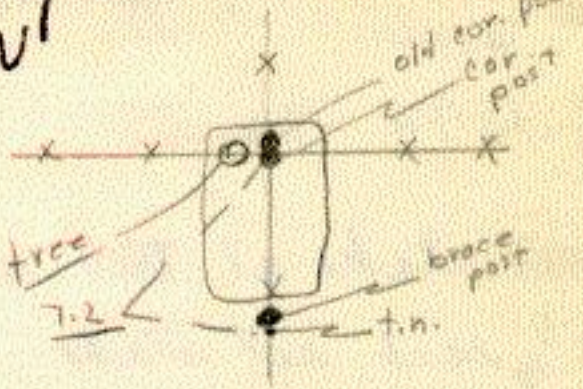

Line from t.n. @ E¼ 9 to @ W¼ 9 @ 2640 From SW 9 would come 2½' N. of t.n. here

Line From t.n. @ E¼ 9 to a W¼ 9 @ Full Hunter From 52 acre Fe. would come 4½ North of t.n. @ Center 9