1 7-23-71 set CIM over stone and 2" x 3' Cast iron pipe.
section corner. 10-11-14-15 Rock Dell 10 5-15
4-22-71 Set CIM over ½" x 2' rod (rod was 3' deep) #55105 (1)
6-1898 Jr Fraser P520 no 486 Lll H Skjerven
found old stake in center road after Peter Hogensen avered
he set his orig corner post 2 rods west & 2 rods south
when stake was standing. altho fence 6' each way in
at that time dug & found orig post remains abd from
that found old stake in road.
- set stone 3 x 9 x 17 as corner in place of stake.
- 1/16 north set stone 3 x 10 x 15 M & L 19.95 3/4 (1317.2)
toward stone set at 1/4 10-11.

7-22-71 Meas from CIM over stone at 2-3-10-11.
to nail set at random point center E-W road & line
projected from mean center line north. over.

7-23-71 dug with tractor extensively after finding.
1/16 and 1/4 stones north. - found limestone 3x9x13 in
dark org soil 5.1' deep thru many layers of rocky road
fill - 1.45' west and 2.28 S of random nail.
Meas north to 1/16 stone found. 1317.41 R. 1317.2
then north 1316.89. to 1/4 corner. total 2634.3 R 2634.4
1/16 corner. .26' N of midway. and .08' east of line between
10-11-14-15 and 1/4 10-11. R5268.8
1/16 corner. .56' N of 3/4 total meas betw sec corners 5267.45
and almost exact line between section corners as set.
as section corner set 2" x 3' cast pipe over stone with
C/M above cast pipe.
as 1/16 corner set 5/8" x 4' rod on S side L stone centering over stone
Lee Card #2

Card # 2. 10-11-14-15 Rock Dell 1.05-15 (2)

#55105


7-23-71 cont'd

RP 10-11-14-15.

42.0 SE To cor ~~nail~~ Good nail on NE side large transmission line power pole # 6929.

43.9 SW To 3 RD steps on ground wire above splice in wire on SE side power pole #1729. void after road grade

25.52 NE to inside edge of culv head wall apt'd

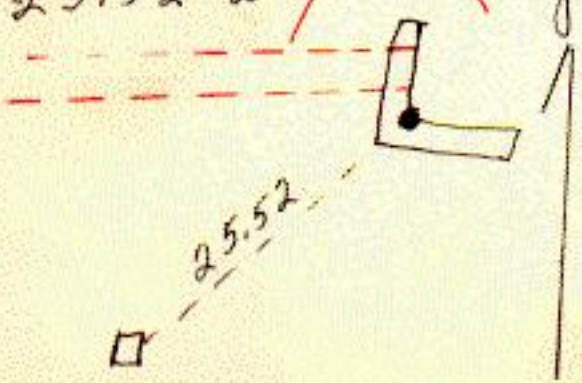

RP 1/16 north of 10-11-14-15.

-35.3 2.7' SW to 5/16 bolt x 3 3/4" sticking out of N side 5" iron post.

-77.6 NW to pipe cap NE side Power pole # 6915 corner 1' east of E road over.

section corner 10-11-14-15 does not come any where near center road intersection.

E-W roads do not line up.

Corner comes about in between centers of E-W roads.

corner comes about 4'+ east of center N-S roads which line up fairly well at intersection

5-26-72 removed C/M for grading deep fill due, set ½" rod.

Zaged near back to County assumed corner at 11-12-13-14

4-22-74 Set C.I.M over ½" x 2' rod

RPs

Co. Surv. 4156 N 2° E 47.72 - SW - 73.34

~~Spruce 6" dia. - P.P. - 69.39 - S.E. - 42.0~~

Punch hole W end 16" dia P NW 47.61

" " E end " " " NE 50.41

Section Corner 10-11-14-15 Rock Dell 105-15 (3)
Set by Michael Karrick 5-1854 #551105
68.40 Creek 8 lks wide runs N.E.
80.00 Set post for corner to sections 10, 11, 14 & 15 Erected mound with trench pitts charred stake and Osage Orange Seeds at each angle.

Nov. 1857 John Follows Pg. 42 No 64 shows Sec. Corner
1/16 west 19.89 chs. M&L to 1/4 Post
See Survey for Interior breakdown of Sec. 10

9/22/88 FD CIM IN GOOD COND. DOWN 12" IN INTERSECTION
TWP ROADS E-W-N-S
RP's Co Hwy Disc SW SIDE OF PP # 6929 SE
41.82', SPIKE IN P.P. TO LOW BECAUSE OF REGRADE,
OTHER RP's OK