8-9-1965 set C/M ones ½"x3' rod on line from south. #552005 (1)

section corner. 19-20-29-30 Rock Dell 105-15.

9-1876 Hunter P 304 no 299 & 29 Marcus Young
Nelson Thurman.


corner gone completely no knowledge of cr.

Meas N¼ 29 to NW cor 30 119.77 chs overran 7 links.
Meas SW 29 to W¼ 20 119.94 chs short 6 links.
set burr oak stake with stones around its bottom as corner.
- meas south 39.98 to stake set M&L 2638.68.
- meas north to ¼ 19-20 39.98 stone found.
- meas east 40 ac
- meas west 40.03½

(See ½ 20-29 H S Gilman for ½ 16 north.

6-1895 H Fraser P 582 no 532 & 19 O Gure etal. (orig)
found corner set P 304. set new stake with limestone

by its side.
- west 1/4 cor gone set stakes at 1/16 each with 1/64 stake
set between afore 1/16 and corner. (SE19) also set S 1/4 19.

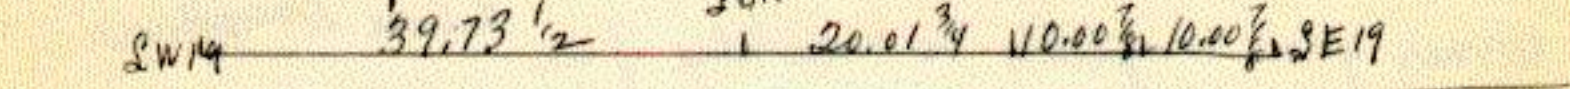

8-1965 J Kerr survey in section 30.
corner destroyed by diagonal 4' Culvert set by town board. set
across intersection. run line in from south over corners found.
retracing survey p 304. also meas from west -
dug extensively along & west of large culvert covered by
farmer. Spotted that corner not remarked in placing culvert.
- set C/M corner 1/2" x 3' rod. at point 2637.46 from E 1/4 30
and 2642.0 from N 1/4 30 set. line projected from south.
corner lies 3/4 west & road south - in center road E & W.
Disc S E side cor post S W 54.3. Center tele control post no 3 N W 59.4
" S W " power pole S E 47.4 Large culvert N end culvert
N W 14.9.

#552005 (2)

Section Corner 19-20-29-30 Rock Dell 105-15

set by Michael Karrick 5-185Y

80.00 Set post for Corner to sections 19, 20, 29 & 30. Erected mound with trench, pits, charred stake and Osage Orange seeds at each angle.

9/3/92 FD CIM IN GOOD COND. DEEP IN RD.