
/ 8-12-71 found stone of record. 10-11-73 set c.i.m. over a 5/8" rod. #552104

1/4 corner 21-28 Rock Dell 105-15

7-1893 H Fraser 523 No 488 L28 Frank Roedel, Peter Lee.
found remains of an old stake Bettol Magnuson
on digging to set a stone 4x4x18 M & L 39.86 (2630.76)

7-28-71 Co surv. set nail in center road in line fence
North and south on transit line from nail in center
crossroads at 21-22-27-28 at 2618.45 R 2630.76
- cont. line and meas west to center black top Co road 3.
2640.05 2630.76 set 5/8"x14" rod as temp cor w/ stone.

8-12-71 found stone 4x4x18 with 12" diam x 22" boulder
lower and slightly South found. 15.9 west and 1.2 south of nail.
- meas east to small stone found 2629.75 R 2630.76
- meas west to nail center B top. 2624.15 R 2630.76
over.

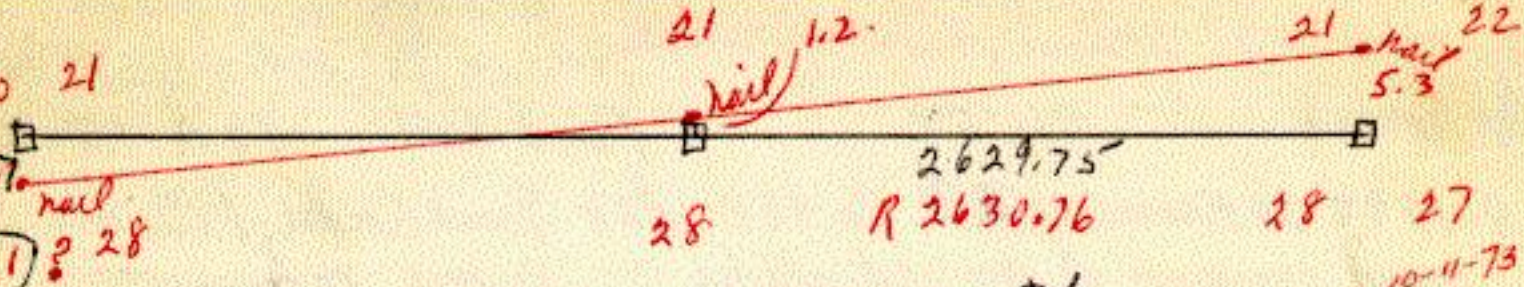

A 2633.0.
R 2635.38

10-11-73
Cone

Corner 16' west of fence running north.
-38.7 NE to 16 O nail in top of leaning post just east of very poor small corner post.
- Corner near center road. East and west.
- corner about 28' west of center field drive north.

nail

10-12-73 C/M now above recorded stone at 20-21-28-29.
- believe 3/4" x 22" iron at 21-22-27-28 very close but should be accurately run

set by Michael Karrick 5-1854
36.60 Road bears N.W.
40.00 set quarter section post in mound with trench, pits, charred stake and Osage Orange seeds N.E. & S.W.