10-25-73 dug entire area found nothing. (1)
10-31-84 CIM

#552504


1/4 Corner 25-36 Rock Dell 10 S-1S

4-1906 Chas Armstrong P 106 B L 36 for N.S. Stiles has "stone" written on plat as N 1/4 36, no mear, no desc. used to set Center 36 which corner in river

---

11-8-71 Co surv projected aerial from 20' upst west of S 1/4 36 E/M over 20' upst west at cross on 1/8 stone 1329' north of S 1/4 36 R 1326.6 could easly see direct to 1/4 25-36 in road. air clear temp 36°

- area has no N-S fences within 80 rods grade filled 3' ± but no abrupt wash area - good chance stone could be in place - set 40 D on North and South edges of road in grass 1 foot over.

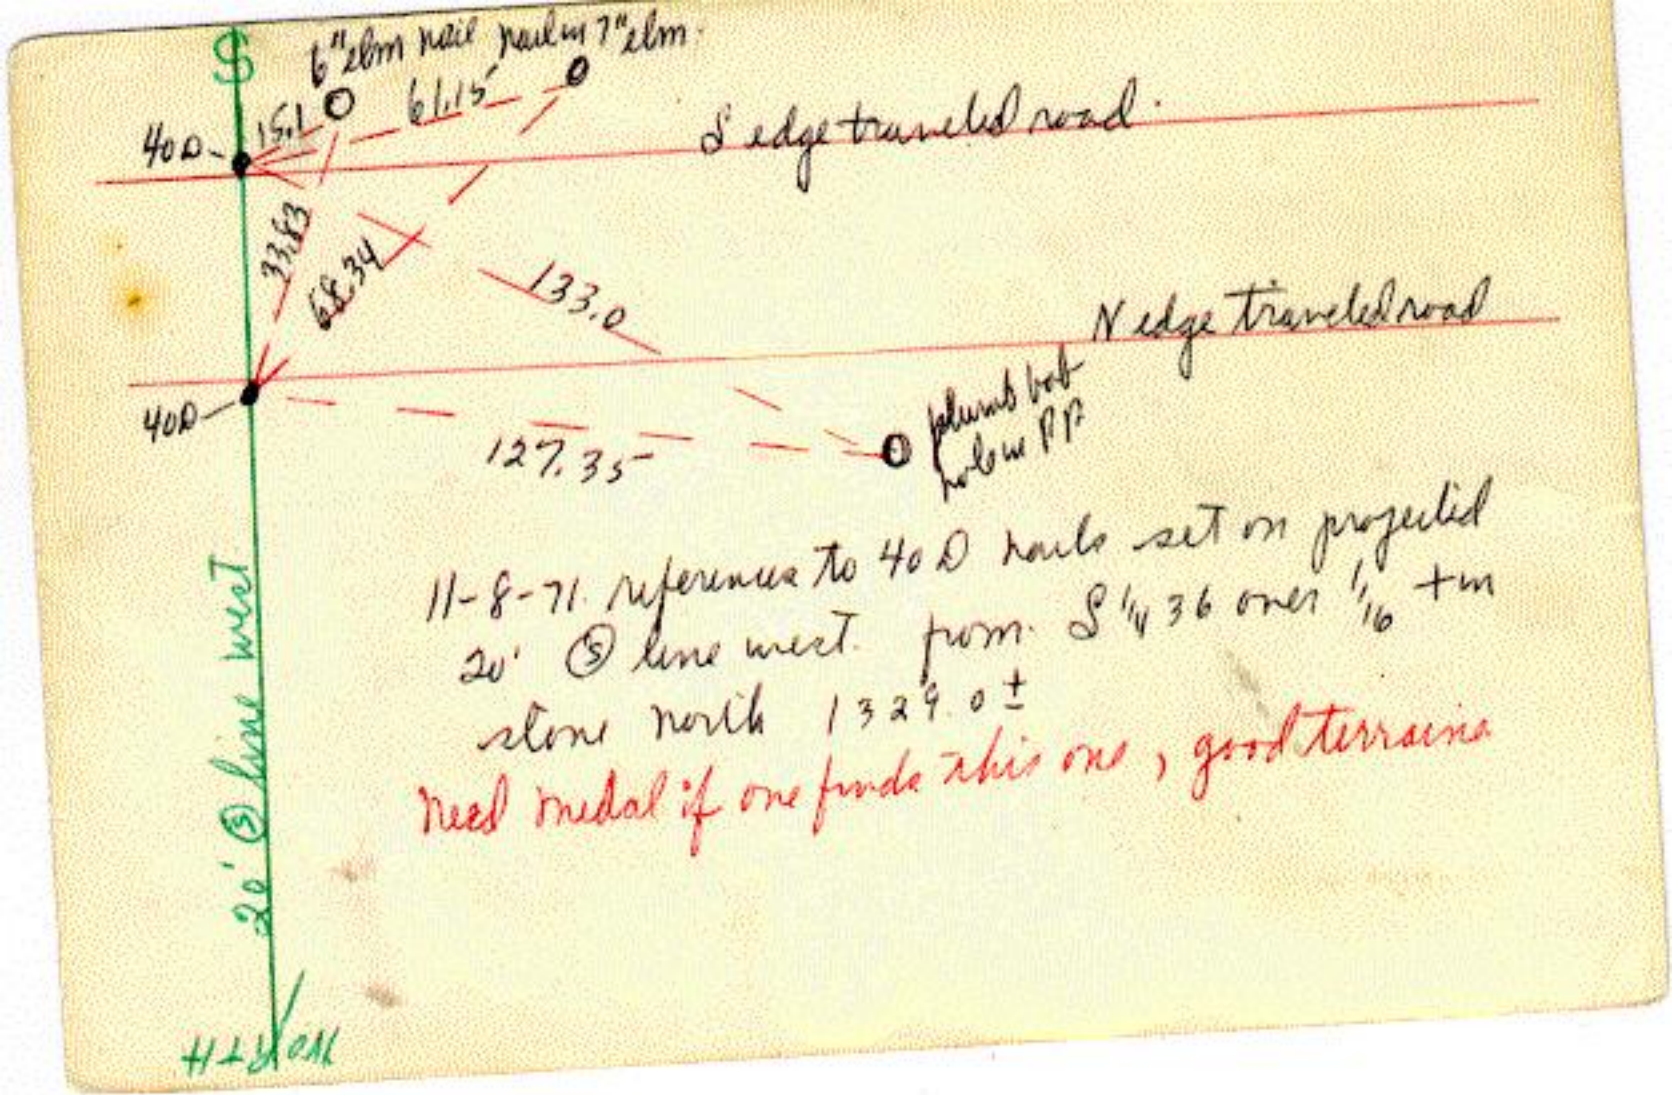

11-8-71 reference to 40D nails set on projected 20' ⑤ line west from S 1/4 36 over 1/16 +m stone north 1329.0 ±

Need medal if one finds this one, good terrain

Card # 2 1/4 25-36 Rock Dell 105-15 (2)
#552504

10-25-73 found 20' offset nails both torn out but not moved very far replaced exactly from RP3

- Meas from C1M at E 25-36 west, found 1/16 property fence south at 1316±. 20' east of offset nails. Corner would come at 2635. did not break west to C1M at 25-26-35-36.

dug entire road nearly from 3' west of 20' line to 5' east of 20' line to clay or water, much blackdirt. found a few small boulders in sub grade near clay but no wood or corner stones. 20' offset line could be checked with farm property corner as 1/16 south but N-S line may be very close (over)

set transit on Brest some 500' west and read line very near center E and west so corner could be put on line and intersect offset line from south or see if midway would come close.
Armstrong corner lost and gone 4 corner set

Set by Michael Karrick 5-1854
40.00 Set quarter section post
Burr Oak 8 S 30 E 4 14
Dug trench

10-26-84, 1/4 Cor 25-36: Found spikes on North and South edge of road set in 1971 on a 20' offset West of line from the S1/4 Cor 36 over Armstrong's stone at the 1/16 North (actually nails replaced in 1973) See 1984 Remon. BK for digging sketch. Dug across road 20' East of nails. Enlarged on 1973 dig. Found a stone boulder 4" x 5 1/2" x 20"

#552504 (3)

1/4 Cn 25-36, Rock Dell, 105-15

10-26 & 29-84, 1/4 Cn 25-36 continued: that had been broken in half, one piece set vertical and the other laid on top



Stone down 3.0'. Removed stone

The way they were placed showed that they had not been broken off by road construction.

There was still black dirt beneath the stones, but at clay line 4.7 deep found 2" diam. mark directly beneath vertical stone and extending into clay 4 or 5 inches. It appeared to be stake mark although now filled with black dirt fairly hard packed - stake possibly pulled out when stone set. Stone 9 1/2' So. of E

E-W road and is 24.6 E off OFFSET line
Found a post stub on the North side of road 8½' N of ℄ and 22.1 E of offset line
There was another longer post on the North side of this post that had been cut off by road construction. Believe these the corner post to previous fence North, and the road probably straightened out.

10-31-84, ¼ Cor 25-36: Set CIM over a ⅝" re-rod at the location of stake mark and stone (removed) found. Corner 9½' South ℄ E-W road and 161' East of center of field drive on North side of road.