#552804 (1)

1

1/4 corner 28-33 Rock Dell 105-15
6-1875 Hunter P283 no 280 S33 A Peters, C Patton.
found fence post set in middle of mound set by A Peters
by side of old govt 1/4 post.
-16 West set marked stake N&L 20.00 (1320.0 S 89°15'W
- East set stake at 22.40 (1478.4' or 2.50 (165.0' east
of 1/16 corner (no described) then 17.40 (1148.4 to boulder
23 x 8 x 6/2 set on testimony of adjoining land owners
total 1/2 mile 39.80 2626.4 with midway 1313.4.
-16 south set stake N&L 20.02 (1321.32' to center 33
bearing west S 89°15'W east N 89°10'E south N 10'W (over

7-1893 H. Fraser P521 No 487 S33 Charley A Roeder.
found mound with remains of old post in center of mound
left as found.

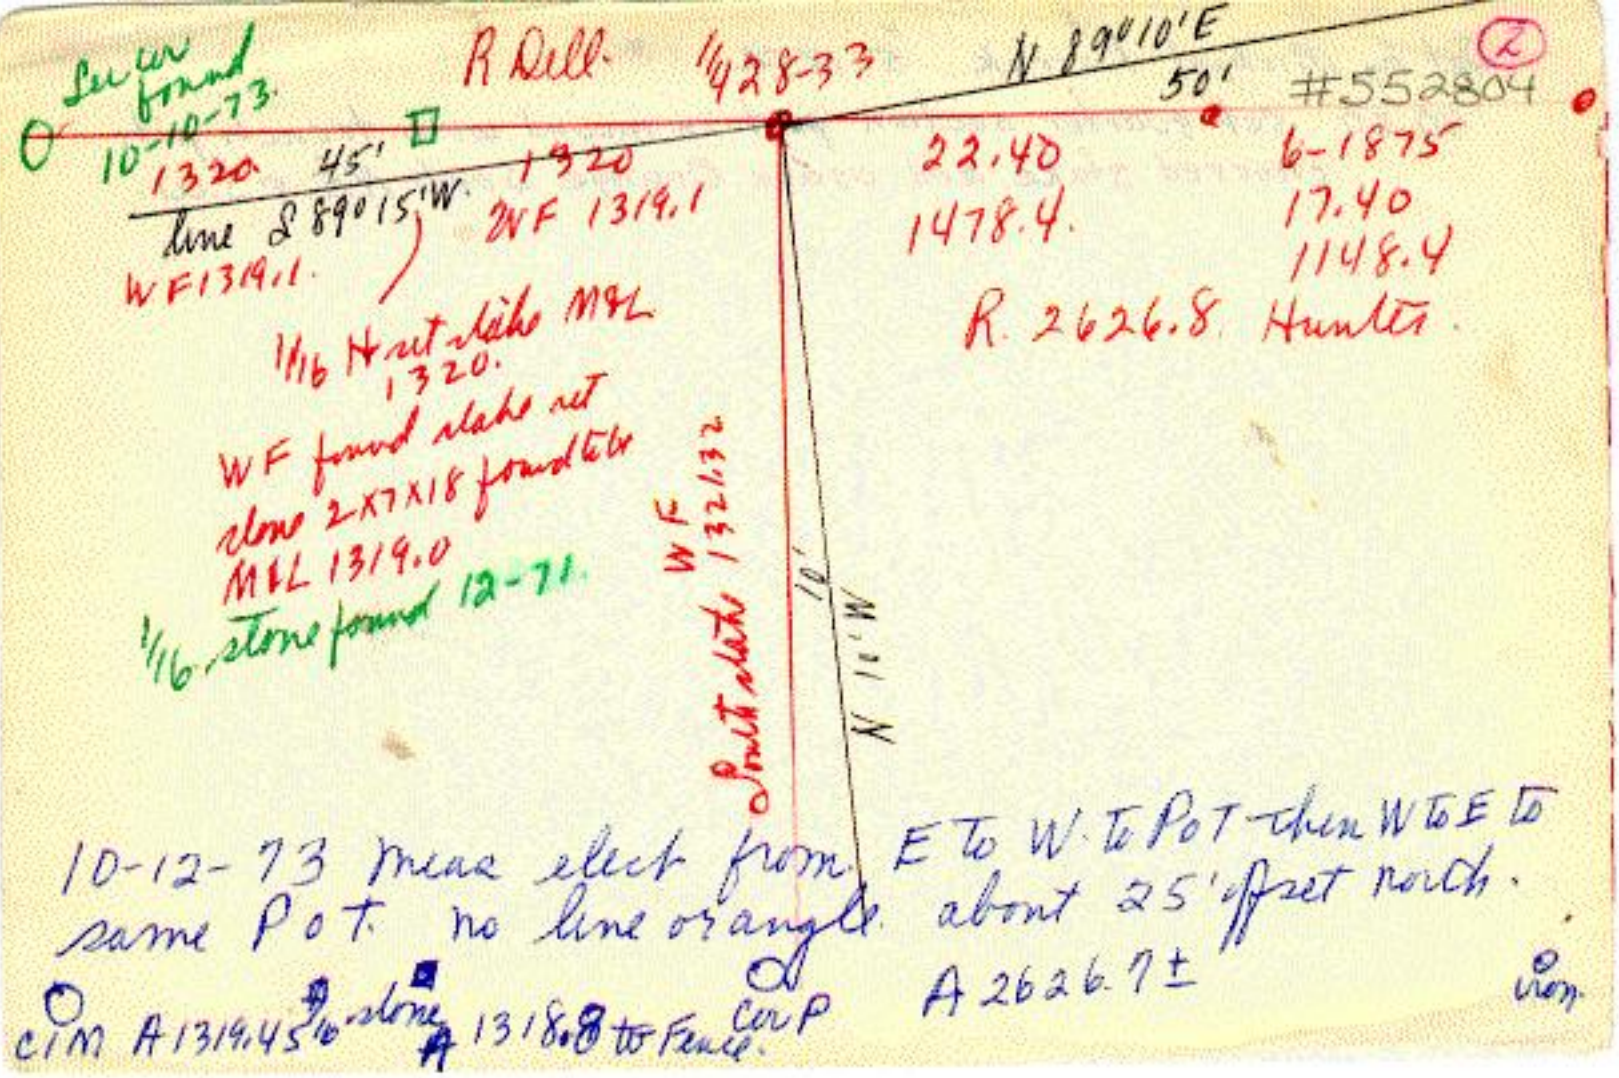
-16 W found remains of old stake set by Hunter P 283
which proved to be N&L 19.98½ (1319.' set stone
18 x 7 x 2 likely in place of old stake.
NW corner 33 found. Hunters stake set stone 2x9x18.

---

9-1893 H Fraser P523 No 488 S28 Frank Roeder
Peter Lee
Bottel Magnesia
used corner and 1/16 corner west as P521
used to set limestone at center 28

---

12-23-71 Co surv. Meas east from nail set in center
black top in 7-29-71, found exact size limestone 2x7x18 = {1/16 West
3' north and 2' east of fence running east and south.
Meas about 1318.8 ± R1319


Sec cor found 10-10-73.
R Dell. 1/4 28-33
N 89°10'E
50'
(2)
#552804
1320
45'
line S 89°15'W.
1320
WF 1319.1
WF 1319.1
22.40
1478.4.
6-1875
17.40
1148.4
R. 2626.8 Hunter.
1/16 N set stake MRL 1320.
WF found stake set alone 2x7x18 found 64
MRL 1319.0
1/16 stone found 12-71.
WF 1321.32
South 1320
12'
N 10' W
10-12-73 meas elect from E to W to Pot then W to E to same Pot. no line or angle about 25' offset north.
CIM A 1319.45
1/16 stone
A 1318.8 to Fence Cor
A 2626.7±

Set by Michael Karrick 5-1854

40.00 set quarter section post in mound with trench pits charred stake and Osage Orange Seeds N.E. & S.W.