/ 8-16-71 found recorded stone. set ½" rod #553109 (1)

¼ corner Center 31 Rock Dell 105-15

6-1875 Hunter P284 No 281 S31 3 Holland Bros. J. McDonough

set stake at inters lines.

1/16 west set stake on line & perp meas 20.15 chen 19.95

computed S meas 39.80 actual 40.10 chen above meas.

-16 east set marked stake M & L 19.95 1816 S E 8° 36' W.

-16 north set " " " 20.01 ¼ 1320. N 3¼° W

-16 south " " " " 19.93 1315.38

-16 center NE ¼ " " " 19.92 on E-W 1/16 line.

-16 center NW ¼ " " inters lines

- stakes set east of 1/16 south 12.97½ chen 12.97½ chen 13.97½.

-16 west

6-1898 H Fraser P 635 No 573 S31 S Eichstadt. J McDonough

found hunters stake in centerroad proved by inters lines (no)

replaced stake with stone 2 x 8 x 20.
-16 north set stake & stone M&L 20.00 ½ conc. at found stake. N 20' E
-16 south " " " " 19.92 " " "
set stakes east above 1/16. 12.96 then 12.96 then 13.96 also.
set 1/16 stake east above 1/16 M&L 19.94
-16 east set stone & stake M&L 19.92½ found Hunters stake OK. N 89 15 W
-16 west set new stake & stone - line & 20.13 - then 19.93 found Hunters stake

---

8-9-71 set nail in center intersection roads in transit random line.
RPs 36.4 SE to SE cor. Conc headwall & N-S culvert
33.2 NE to NE cor. " " " "
Nail set 2626.2 from random nail set at ¼ 31-32
1316.27 from random nail set at 1/16 east

8-16-71 found large wood post and limestone 2 x 8 x 10 with decided road surface near top of stone indicating that top of stone could have been broken off by road action.

Card # 2. Center 31 Rock Dell 105-15 (2)

8-16-71 Cont. found described corner. .9 south and .2 east of nail set. #553109 W Fraser.

Meas east to 1/16 stone found. 1315.32 R 1315.05

Meas east to pipe found at 1/4 31-32 2628.92 R 2630.4

set iron rod as temp corner, near ones stone found.

No further R.P.S.

1/16 corner east of Center 31.
1/4 31-32 found 1.2 N 2.5 E. 00 nail.
set nail on random line at 1312.35
found limestones with wood stake between stones
.5 N and .75 W of nail. or at sta. 1313.6 from pipe WF
R 1315.05
set 1/2" x 4' rod. thru old wood stake.
corner in direct line fence running south - no north fence
43.36 S to nail on west side corner post of fence south.
141.2 ENE to orange cap on South side power pole # 6245
Meas west to stone found at Center 31 1315.32 R 1315.05
Corner should go west .86 to be midway of 1/4 31-32 base
true orig corner which it cent Corner should be left as is
random line came 1.2 S at 1/4 31-32 .5 S at 1/16 E. .9 N at Center
1.35 N at 1/16 W 1.87 N at pipe W 1/4 31

Card # 3 Center 31 Rock Dell 105-15 (3)

#553109


S/16 corner west of Center 31

8-9-71 set nail corner area on random transit line

Nail came 1312.85 east of nail set as W 1/4 31

8-17-71 dug with tractor found small limestone and very pointed wood stake 2" x 24" - set short 1/2" rod as corner. under proven and accepted as corner found 1.35S 3.7E of nail. - corner lies .24' south of direct line betw 1/4 corners as set of E 1/4 and center used as line corner would have to move much further south than it now is. using center as is and W 1/4 as found it would be very near on direct line within .05'

over Random E-W line

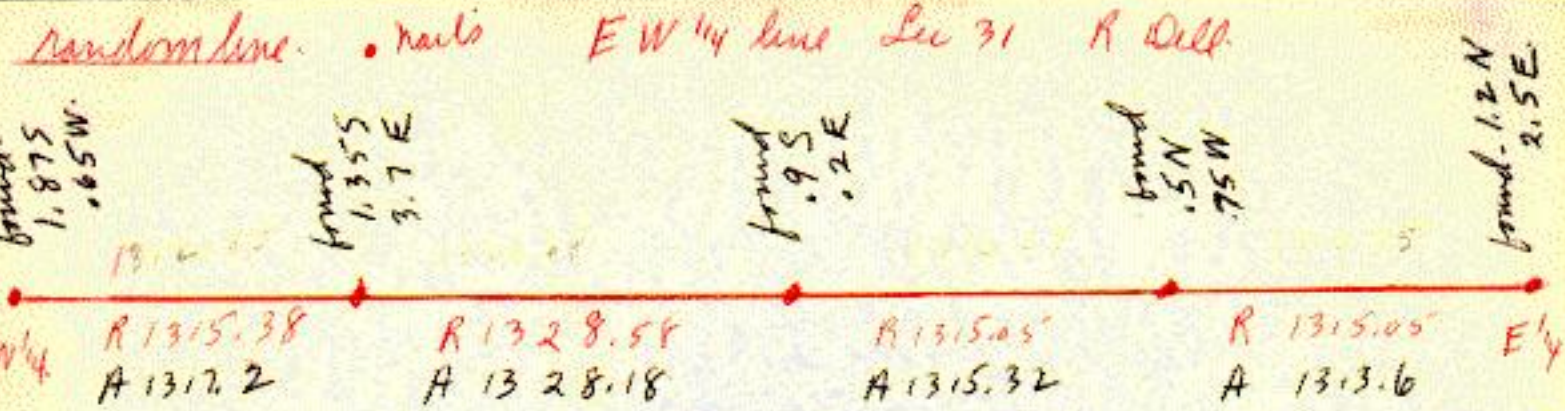

11-3-78 1/16th South: found a stake with a chattered limestone on the South side 1' deep in road. Corner is [illegible] main road further N and in line with fence East.

T.N { 7.90W 7.43W
Stake { 8.20W 7.53W