
2/40 V.F. FD Bolt w/1" SQ HEAD #353205 (1)

section corner south 31-32 Rock Dell 105-15
6-1875 Hunter P 282 no 279 L 32 C H Roeder.
A Peters.
Corner standing in mound, used to
set 1/4 31-32 M & L no meas given.

6-14-1875 Hunter unrecorded. L 5, 104-15 Micheal
L E 31 given as 5.51 east of N 1/4 5 Eichstaat.

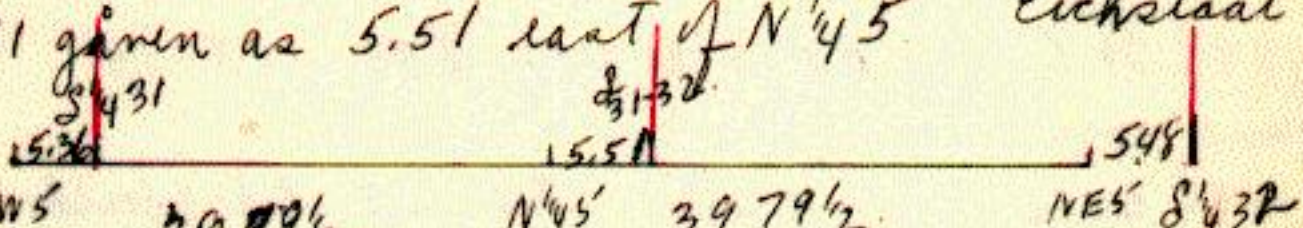

6-11-1875 Hunter P 284 no 281 L 31. 3 Hollands. McDonough
found orig stake standing in remains of mound at corner of field
ones)

1/16 north. set temp stake M & L. 19.96. N10W
- west set stakes at 13.98 1/3 then 12.98 1/3 then 12.98 1/3 to S 1/4 31.
- west of 1/16 north set stakes west at 13.97 1/2 then 1297 1/2 then 1297 1/2 to

6-1898 Jt Fraser. P633 no 572 S5 - 104-15 1/16 cor.
found post in mound covered Just Eichstaat Jon Hagan.
by Mr Holland that he set post in place of stake.
5.51 east of N 1/4 5 - 6" burr oak N 28 1/4 W 22 lks.

6-1898 Jt Fraser P635 no 573 S31 105-15
found corner P633.
1/16 north couldnt find Hunters stake set stake & boulder M & L.
- west set stakes at 13.98 then 12.98 then 12.98 to S 1/4 31. 19.95
- west of 1/16 north set stakes at 13.96 then 12.96 then 1296 to 1/16 cor.
also set stake at 1/16 west for line north M & L 19.94.

#553265 (2)

No (2) card south 31-32 Rock Dell 10 5-15.

6-1923 J Kerr P 392 "B" Book-8 page 11. Honorary.
uncompleted survey.
found stake replaced same.
1935 CHD set stake in ½ Book 79

1940 Co Hwy Dept B109
found 3/4" bolt 6" south corner post.
362.8 east & N 1/4 S 363.66 is record for 5.51 chs

9-1853
~~50.00~~ 53.70 Creek 20 lks wide runs SE
80.00 Set post for corner to sect. 31 & 32 built mound with trench per instructions drove charred stake in center & planted Apple tree seed on N.W. Corner

2/90 Vince Fangman FD. BOLT W/ 1" SQ HEAD
DOWN 1.0' RP's
30d. IN 24" OAK NNW 31.81'
30d. IN CORNER POST NW 1.37'
30d. IN 18" OAK NW 78.03'
1.2' E. AND 0.8' So. OF CORNER POST