#553304 (1)

t,

1/4 corner south 1/4 33 105-15 Rock Dell.


6-1875 Hunter P283 no 280 S 33 A Peters, J Patton.

Corner gone. B trees gone. Much brush & high water at this time. Meas east from SW cor 33 see P282. 40.00 for line north.

6-1877 Hunter P319 no 313 S. 3104-15 J Brewer, J Saulsberry, J Rickert.

Corner gone as well as all corners from NW cor 3104-15 (stone in post hole dug) to SE cor 33 (a stake in mound)

- corner must come 40.13 from section corners E & W and record says goes notes 5.35 east of NW cor 3.

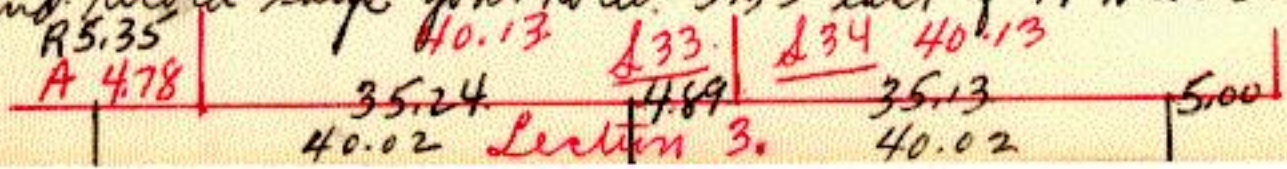

(over)

In other words corner really never set just passed over.

1935 Co Hwy Dept B79.
found nothing used fence corner

9-1853
0.43 Creek 50 lks wide runs S.E.
18.00 Same Creek & Enter timber bears NE
19.00 Creek 40 lks wide runs N.E.
26.50 Same creek 40 lks wide runs S.E.
27.50 leave timber & Enter prairie bears N.W.
40.00 Set qr sec Post
{Burr Oak 10 N 83° W 28.5 lks
{Burr Oak 10 N 57° E 10.7 lks.

#555304

1/4 corner South 1/4 33 Rock Dell 105-15

11-22-93 Dug for T. Hunter stake set 2640' from west. fd Post hole .60' west of T.N. also gray spot running into clay .65 E & .10 North of T.N. We fd a 2" diam. Black soft spot running 7" to 8" into clay ± .60 west & ± 3.1 North of T.N. We dug South to cover T.H. distance from Center of Section 33 fd post stub at clay Height running 2' deep in clay. The oldest post of these that we fd. It was ± 2' So & .5 west of T.N. We also fd a 3" diameter black mark running 1 1/2' deep into clay getting smaller at End this is ± 4' So of T.N. & ± 1' East of T.N.