
X

#553305 (1)

section corner south 32-33 Rock Dell 105-15
6-1875 Hunter P282 no 279 L32. C Roeder, A Peters.
found orig stake in clump of willows covered as to
where it always stood although 70 lks short west to
L ¼ 32 and way out of line going north.
1/16 west set stake flush with ground surface M & L 1965
- Meas north 40.06 N10°E then 40.06 N1°W to NE32.

6-1878 Hunter P351 no 343 L 4-104-15 John Wilmont
found orig stake as described P282. as "L"
- meas west to L ¼ 32 as M (orig stake) = 39.41

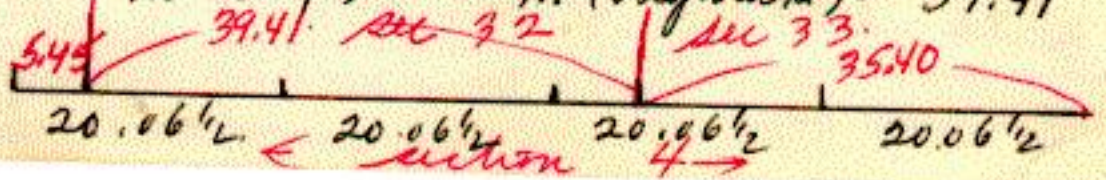

6-1877 Hunter P [redacted]319 no 313. S 3 104-15. J. Brewer
used "established corner" at S W 33 to | J Saulsberry.
mear east 2 miles to SE cor 34 160.53ch | J Ruckert

7-1893. W Fraser. P 521 no 487 S 33 Charles Roeder.
found stake P 282 set stone boulder 6x6x18 in place
A stake. - Dist 4.71 1/2 (311.2) to N "4 4 104-15.
called "N" found stake set stone boulder 6x8x16.
5/16 east set boulder stone N & L. 20.03 To NE cor 4a stone.
also road layout.

6-1923 J Kerr. P 392 B. S 32. Hennessy.
found stone as described by Fraser.
Mear north 2644 to Corner also 2644 north to sec cor.

1935 Co Hwy Dept. B 79 found notching set stake N & L
on Twsp line betw "4 cors.

#553305 (2)

Section Corner South 32-33 Rock Dell 105-15

9-1853

80.00 Set post for corner to sect 32 & 33 built mound with trench per instruction drove charred stake in center & planted Apple tree Seed in N.W. Corner Elm 20 N 26°E 169 lks

11-16-93 Dug for W.F. Stone set @ T.H. Stake location using W.F. 4.71½ chs. From ¼ line in Section 4 104-15. We dug to cover full measure from ¼ Cor 32-33 by T.H. and North 6' using line from East. Dug 1' west & 3' East of T.N. Clay was 1' deep.

Cont. over →

11-16-93 cont. This area is 15' below bank of River @ flood line. We found nothing.

11-18-93 After finding N¼ 4-104-15 We Dug again North of previous Digging. Fd W. Fraser 6x6x18 stone with stake on East side 1.8' deep to top of stone. The stone is in line with fence west & is 4' North of diag. fence running SE-NW. Set Post & Sign on North Side.

Section Corner South 32 33 Rock Dell 105-15

#553305

11-19-93 Set CIC/P² at W. Frazer stone location. Placed stone on North side of monument. CSD in Brace Post SW 3.25'. Sign & Post 1' North.

11-18-93 1/16th West of S 32-33

Dug for T. Hunter stake We dug from 1' west to 3' East of T.N in line of fence North & 1' South of ✝ Iron C.P. in Concrete to fence E-W-N We fd a post stub leaning Swly from stones piled around it. 1' East & .5' North of T.N. We found a soft dark spot running down ± 18" This may be Hunters stake location it falls SE of Post Stub This spot is 1.9' East & ±3' So. of T.N.