/ 8-5-71 set C/M over. stone & iron found. (1)
#553400

1/4 Corner 33-34 Rock Dell 105-15

6-1875 Hunter P283 no 280 & 33 A Peters, J Patton

found stake in center road aneed by Mr Patton as where original 1/4 post stood. drove new stake "well down" with stone 7x8x14 on top of stake - stone also well below road.

-1/16 west set stake M & L 20.02 1321.32 to center 33. (S 89½° W. stake)

-1/16 north " " " 19.98 1318.68 to NE 33 (stone set N ½° W)

-1/16 center NE 1/4 set stake M & L. 19.96 on 1317.36 E-W 1/16 line.


also set stake 2.5 chs east of above 1/16 cor. (center NE 1/4).

7-1893 W Fraser P521 no 481 & 33 Charley Roeder.

found stone boulder as recorded P283

over)

6-1902 W Fraser P 21 B. L 33. D O Patten.
found corner and set iron stakes in place of all
stakes set by Hunter. on E-W 1/4 line marked O

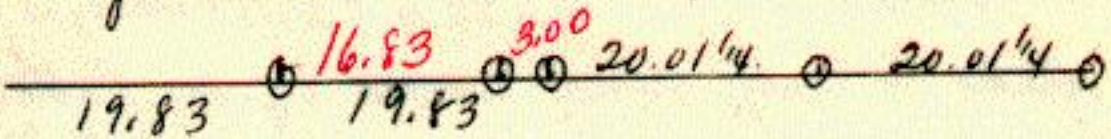

8-5-71 dug with tractor at center tee roads and line of
fence south. - found exact record size stone with iron below
stone 5' deep. set stone & iron back with 8" piece of
chrome tail pipe over stone with C/M on top.
- Meas north to W Fraser stone found 2646.4.
- Meas north to Hunters recorded stone exact size
2634.9. R 2637.36 or 11.5 south of W Fraser corner.
- Meas west to center 33 found. 2642.83 R 2642.64

Card #2

Card # 2. 1/4 33-34 Rock Dell 105-15. (2)

8-5-71 Cont. RP to C/M set at 1/4 33-34 #SS3406
corner 2' North of center road E & W
3' west of center road N
perfect line with fence running south.

62.8 NE to ø in d end 24" galv farm drive culv

30.9 NW to cone nail on NE side power pole # 6274

28.06 SW to cone nail on SE side power pole brace #6275.

Meas west to 1/16 mon found in place. 1322.5 when
1320.33 to center Must go 1.09 E to be midway.
or 1321.41 R. 1321.32

Set by Michael Karrick 5-1854

40.00 Set quarter section post
Burr Oak 10 N 58 E 168
Dug trench