
L 6-21-71 set CIM over pipe & stones found. #553606 ①

1/4 corner 35-36 Rock Dell 105-15

5-1895 2t Fraser P574 No 525 S36 J Purson & others.
no evidence or knowledge of corner could be found. set stone 3" x 12" x 12" with stake by side the stake being true corner.
set M & L 40.02½.

6-1924 Boyce Co HD B 39 P 40.
found corner stone RP tib PSW-42.8 } F.P. SE 36.5'
Mens east to PI 1702'
then 36° N 700' then S 700' 36°
RP"A" cottonwood SW 39.5
FP SE 41.5

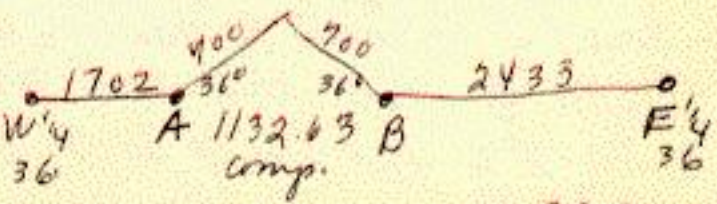

over RP B.

spike in oak tree S 23.4
" " " " SW 16.4

11-1906 Ch Armstrong P106 B
found stone (witness) located center (in road) and 1/16 E of center
6-16-71 Co surv meas from nail in center intersec at NW 36 set
by deed meas from school lands 2641.65
R/Rail - 0.0 NE in center E end road culv 25.7
Mark on L stone over center W end gate road culv NW 27.35
Center top of east guard post E of S. 20.19
dug 6' deep over considerable area 3 to 3½' E & W of rail 2½' N & S
over 5' of road fill to clear black gumming soil hard to probe
- doubt if Fraser corner would be in upper road fill. also
doubt if Boyce ever had original Fraser corner as
center E-W road would be at 2648 at least - Must find NW 36.
Note B39 P33 to 40 Traverse of road calls ± 11' south of corner.

Card # 2 1/4 35-36 Rock Dell 105-15 #5536062 (2)

6-21-71 after finding S35-36 6-18-71 and 25-26-35-36 dug small hole and found recorded stone with stake by its side (recorded as true corner). and large split stone near as witness - set 1/2" pipe thru stake remains as true corner leaving orig stone & placing witness stones either side. - stone found 2.6 west and 3.15 north of 2641.65 rail. 32" deep. set CIM & glace over pipe.

- Corner as set lies 2639.65 south of 25-26-35-36.
" 2639.4 north of S35-36 (fork stone
corner lies only .04 east of direct line as set.

corner lies 2.6 W center road north
11.0' N " " east. west.

16 Dia small knot in NW side tele pole.	SW	43.57
Center concrete box culvert ±	SW	40.45
" " " " "	3' N & W	35.2
Chisel mark on lime rock over center 24" galv culv	NW	23.2
punched craze extreme E end culv	NE	26.14
Paper cap NW side PP 6351	NE	46.8

Set by Michael Karrick 5-1854

40.00 Set quarter Section post Burr Oak S 54 W 5.10

" " 10 N 20 E 1.10