1 Be Suspicious – Kleinschmidt Corner #603006 (1a)
probably M+C

X set CIm 6-18-1984

1/4 Corner east 1/4 25 Doner 106 – 11

Winona County

No records

Minn Hwy Dept assumed point from RP's Wash out.

MHD apparently 1960± MHD 3/4" Rod ~~2 1/2"~~ to ℄E cor 25 ~~B 180~~ (See over sheet)

MHD Disc	cor fence post	NW	3.65'
" "	18" oak	℄E	11.7
" "	" "	℄	13.15'

Archie notes B 180 P 76 say 2635.7 to ℄E 25 ?

See Cert. of Corner location by J. Kleinschmidt (March 1966)

Method of Setting Corner unknown – see Cert in Note Book File (Over)

Gov'T Notes: 1853

North 40.00 chains – Set Quarter Section Post

B.T's White oak (No / Size) N 55°W 49 links = 32.34'
Burr oak (No / Size) S 82°E 66 " = 43.56'

Creek 3 links wide runs N.W – North 5 chains


Co. Hwy Dept 1943 Field BK 180 p 76 - 78
by C.A. Armstrong. Survey was
To set Corner at East Sec Cor 25 - 36
Fd Twp Cor Stone Mound South 1 mile and
fd 4"x8" stone with Top Broken off at E 24-25
Split dist (5267.1 - 5267.1) to set Sec Cor E 25-36
and in line of fences N + S
At E 1/4 Cor 25 (A_3) found an old rotten stake
or fence post butt in line with fence running East
and about 1' East of N-S fence - meas 2631.4 N.
(Apparently Nothing else set to identify Cor) 2635.7 So

(2)

Rec'd from MN/DOT 5-29-1984 RLB 28

These notes dated Appx. 1960

NE	Cor Sec 25 Dover Twp
	Not Found
E¼	Cor Sec 25 Dover Twp
	Dug For Cor. Found Nothing in Hole
	Area. Found old Fence Line 1½ Ft So of
	Present Fence. Farmers Said That Single
	be It. Measured From SE Cor Sec 25 To
	The old Fence Line 263± Ft. Thence E.
	Assumed
Post	690° Ahead of PI Sta 11+43.50
	Spk in Fe Line
SE	Cor Sec 25 Dover Twp
	Found Spk. over Boulder in Z
	Of Road Placed By Co Eng.
	See Sec. Cor. Book for Ties

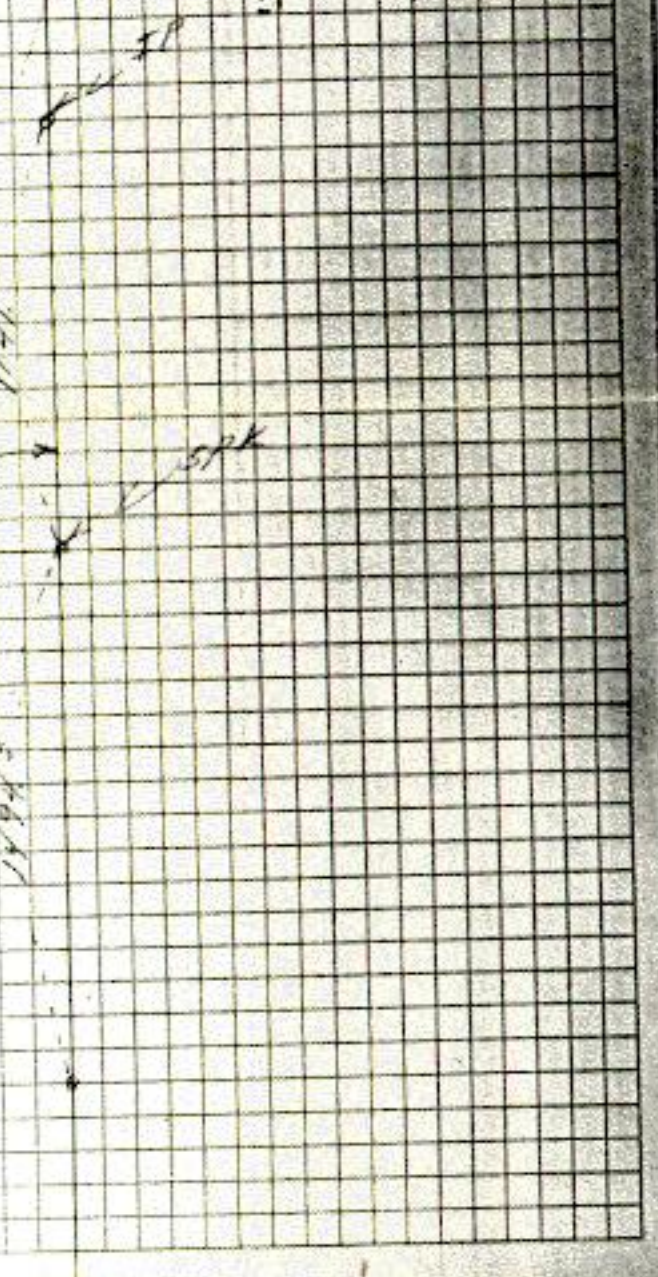

#603006 (3)

East 1/4 Corner 25 - Dover 106-11

6-1984 Tom Ferguson - Survey in Sec. 30-106-10
Fd 3/4" rod set by MN/Dot ± 1960 at their assumed location which is ± 4' e & 2' south of the corner post in place.
Also Found Kleinschmidt's pipe which is about 20' west & 2' south of corner post leaving about 24' between the 2 fd. irons.

6-18-1984 Co. Surveyor - Set CIM over 1/2" iron rod as 1/4 Corner — used line of E-W fence at a Point ± 190' East and E. 1/4 Co. Stone as per Tom Ferguson Survey - used line of NE 25 over a large Ctnwd Tree at 1/16 South of NE 25 and also line of

C.A. Armstrong Corner location at S.E. 25 over a Post (old Corner Post of fences N-S & East) at the 1/16 th location North of S.E. 25. These two lines produced To this 1/4 Corner came about 2' apart, we split the 2 feet and set the CIM at a split for E-W location.

CIM set is about 6.5' west and 3.2' South of the Mn/Dot 3/4" iron rod which we now removed. Also we are 17.53' Easterly from Kleinschmidt's pipe which remains inplace.

Dug small hole 3' E-W x 4' N-S centering over location, set CIM, dug down to yellow soil. Comer 6½' South and 2.3 West of the C.P. to Fence East and South but in line with main line of fence South and East

(cont.)

E. 1/4 Corner 25, Dover, 106-11

603006

6-18-84 continued:

RP's:

SRP in SW side 22" Burr Oak SE 13.97

Spike and C.S.D. in East side 20" Burr Oak NNE 60.10

Center of 21" Burr Oak NE 66.6

SRP in NW side C.P. NNE 5.97

See 1984 Remon Book for ↗ to Kleinschmidt pipe.

~~1853 Govt Notes John Batt Deputy Surveyor~~
~~North between sections 25 and 30~~
~~40.00 chs. setquarter section post~~
~~white oak N 55° W 49 links~~
~~Bur Oak S 82° E 66 links~~
~~45.00 chs Creek 3 links wide runs NW~~