X 9-2-75 found engraved Mons.

section corner township corner County line

SE 36 Dover 10 6-11

NE 1 Elmore 10 5-11

#60305

4-1891 Thos Fraser P476 No 455 & 1 M Hays found engraved township corner stone.

3-1900 Robt Fraser P674 No 599 & 1 Fromell found engraved township corner, set by Hunter & Hayes - 1/6 south - drove stake N & E 20.02 for line west set stake at Center NE 1/4 section 1

Chas

Co H [illegal] 1950 4/76


found buried stone at fence corner

- then North to old fence post at E 4.36 26 32.3

then 2634.8 North to last 25-36

[illegal] Co H notes 6/1963

N 8 chains running from S. — to [illegal]

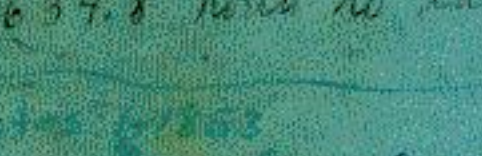

2 Brs Black Oak N 45° E 24 links

Black Oak N 18½ W 32 "

Black Oak N 4½° E 62 "

Black Oak S 70° W 36 "

4-2-75 found Twp. monument at edge of cultivated field and just NE of large oak tree as corner to fence E-W-S

Set ½" rods on E and W sides. Corner 2' E of fence S. and 2.5' N of E-W fence

RP's Spike + CSO NW side large Blk Oak SW 3.3

SE 36 Dover 106-11 TWP Corner
NE 1 ELMIRA 105-11

[redacted] (2)
603105

7-21-98
Found TWP Monument (Engraved) Set Post + Sign 1' South

"603105" D

SE 36	DOVER	106-11	TWP CORNER	7-22-98
NE 1	ELMIRA	105-11		LPA LL

FOUND TWP MONUMENT (ENGRAVED) SET POST & SIGN 1' SOUTH.