1 9-13-73 found 8"± d old stake in fair shape (1)
set 5/8" x 30" rod with small 3/8"± rod token ext. 3-75
11-28-73 set C/M lowered 3/8" x 16" riser rod.

#610906 final mear
Sec 1/4 7-8

1/4 Corner 8-9 Doner 106-11


6-1900 Robt Fraser P686 No 610 d 8 Geo Haff + others.
stake recorded set here but dug extensively and found
nothing. set dry burr oak stake with small
stone beside. evidently 40.17½ N & L. 2651.55

— 1/16 west - drove stake, stone by side 20.00½ N & L.
1320.BB

---

9-13-73 dug extensively entire road N & S from
line fence. running north to 6' or more east and found
nothing. ac fence from south seemed to run to point
some west dug west on north half of road. over

easily found 10 inches & very definate recorded.
dry burr oak stake - saved stake for office display.
stake found 3' ± west and 3' ± north of center
road & fence line north. - set iron stake as temp Cor.
Meas west R. 2640.66 to Center (dug found nothing) 5/8" x 30"
then ran traverse direct line west (see notes)
R P iron one stake replacement at 1/4 S-9 Doner
50' 3' E & N to 3/4 x 20" iron pipe under fence driven flush
49.45 SE to east edge title cable warning post
below traverse.

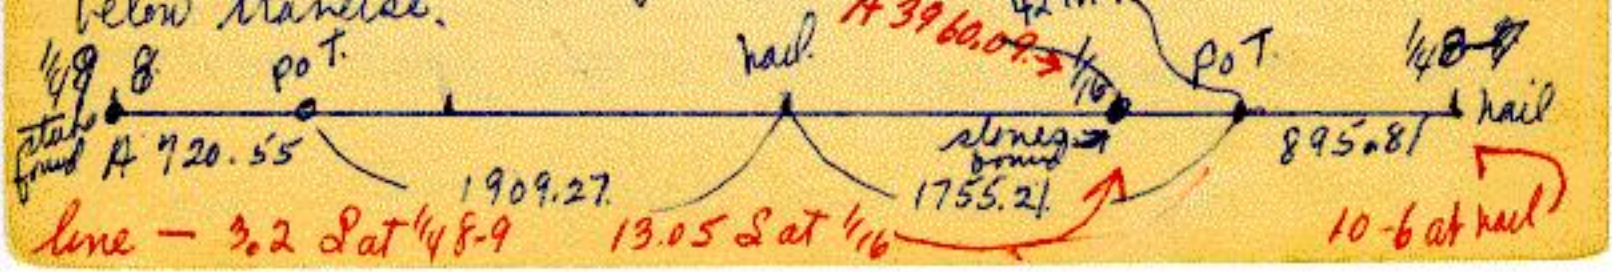

1/4 CORNER 8-9 DOVER 106-11 #610906 (2)

GOV. NOTES -1853 - J. BALL
SET 1/4 SECTION CORNER POST M+L 40 chs 2640 -

10-1983 Found CIM OK but head broken off.
Corner 4' West of Fence North and 3½' N ℄
E-W road