11-2-1979 Set C.I.C. on Telepar as Corner #612204 ①

1/4 corner 22-27 Dover 106-11.
4-1871 Perry by Hunter P182 No 193 S27 N N Pcks.
found stake as 1/4 cor near fence corner.
-1/16 south, set stake N & E 19.91 ft. for line west.

9-1889 Thos Fraser P435 No 422 S22 Garnish
found old post hole with part of post in it, Rucker
claimed by settler To have been post by stake found
in mound. P181
set stone in post hole. no mene or 1/16 cor.

over)

5-1895 H Fraser P568 No 520 S22 F. Hart
M. Taylor.

corner gone., plowed out, land changed.
Lands and no one knew where corner had been
- run line south section line 22 and N-S 1/4 line
over known center, set stone at Inters lines
- 1/16 east set stone MEAS 39.76 N & L 20.06 - (1323.96
GOV. NOTES - 1853 - J BALL
SET 1/4 SECTION CORNER POST N+L 39.98 - 2638.68

10-12-1979 Dug at nail set on South side of C.P. Found a 9" x 11" rectangular mark in clay 2.5 East ~~out~~ of the t.n. There was a small piece of limestone (about 6") standing at the N. edge of the mark (N 2.5 E and .4 North of the t.n) — continued —

#612204 (2)


1/4 Corner 22-27 Dover 106-11

10-12-1979 Continued: The square mark was just SW'ly of a large round mark we believed to be the location of an old corner post. This spot was pointed out by Mr. McDougall as the former corner post location.

10-12-1979 [redacted] 1/16th East: Dug out the stone found standing on the NE side of the stub of corner post. The stone was 3½" x 10/13 x 22" long. Dug centered 8' North and 7' West and found stone set by William Fraser, stone 3" x 10/9" x 18" in pasture and was 8.03 North and 6.37 West of the traverse point.

10-16-1979 1/4 Cor 22-27: Dug to cover double the line and measure from NE 27 (found) over the stone found at the corner post at the 1/16th East (Not Frozen 1/16th) We found a 10" x 11" rectangular mark 1' deep in clay. The mark contained bits of wood and rust and rusty nails. We scraped the mark down 1' and when it disappeared we found in the SE Corner a 2" to 3" diameter black mark. We shaved down the ~~blue~~ side and the mark continued down 6" into clay and tapered to a point. We drove a 5/8" x 17" iron through the mark with a horse shoe around it to retain this location. This point is 13.74 South and 14.53 East of the traverse nail.

Dug

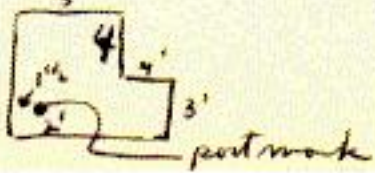

#612204 (3)

1/4 Corner 22-27 Dover 106-11

11-2-1979 Set a CIC on telspar driven over a 1" sq by 35" pipe on the line from NW 22 to NE 22 and at double the measure from NE 22 over Will Frasier stone at the 1/16th West. This location is on the South edge of the square mark white limestone piece we found 10-12-1979 and is 2.5E East and .6 South of the t.n. 1½' South of fence East, 2' East of the fence North and 2.8 SE of the corner fence post with Survey Marker Sign

9-6-95 MnDOT FOUND CIC AND TOOK RPS.

CN + D SOUTH SIDE WOOD FENCE POST NW 2.66'

CN + D SOUTH SIDE 1/2 WOOD [redacted] FENCE POST WNW 9.74'

CN + D EAST SIDE WOOD FENCE POST NNW 16.78'