5-10-77 CIC
5-14-82 CIM

Card No 1

Section Corner 1 28-29-32-33 Dover 106-11

#612805

Govt Notes

80 chs set sec cor. post
made mound, pits, trench

5-10-77 Set CIC/$_{P^2}$ on the corner at double the line and measure of the 1/16th South. Corner 17' N ℄ E-W road and 59' E of ℄ of Rd. N.

R.P.'s: CSD in pp #2002 NE 39.87 removed 5-1982 and I put higher

CSD in Telephone pole SW 85.00 gone 5-1982


"I" Mark in North end 8' x 10' concrete culvert changed 5-1982 W 28.44

9-1980 Sec. Cn 28-29-32-33 : Took reference bfore road grading :

Set a pipe #1 152.29 SW in pasture and on line to a pipe (EDM) #2 128.50 (dh) farther SW

Pipe #1 is a ½"x24" pipe. It falls 4' South of the fence on the South side of the ~~fence~~ road West / -Spike in knee post E 35.2

Pipe #2 falls 70.5' South of the fence on the South side of the road West

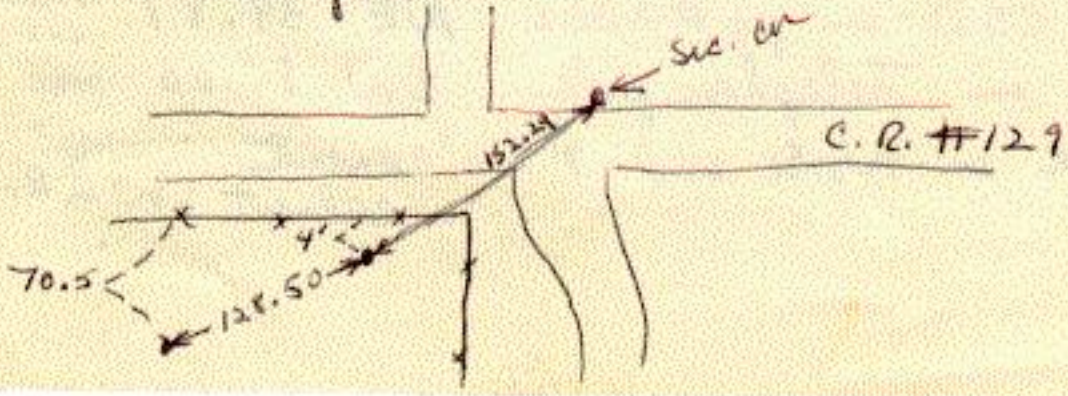

#612805

Section Corner 28-29-32-33 Dover 106-11 Card #2

5-14-1982, Sec. Cor. 28-29-32-33: Found pipes set SW in pasture 9-1980 and set CIM over 5/8" smooth rod from them as corner. Found spike at corner location but badly bent (removed). The corner is now in ℄ E-W road and 56' East of ℄ road North and 25' E of ℄ road South.

- We removed the CSD in pp # 2002 placed 5-10-1977 and put a new CSD higher on the pole and level with the road surface NE 40.02
- Drove P.K. nail in top NE'ly end huge new concrete culvert NNW 35.07

The telephone pole with CSD taken 5-10-1977 is now gone.