9-21-73 set C/M. direct on stone found. (1)
C/M very shallow. R.P. carefully. cut. 3-75
section corner south 31-32 Dover 106-11.
North 5-6 Elmira 105-11.
#613205

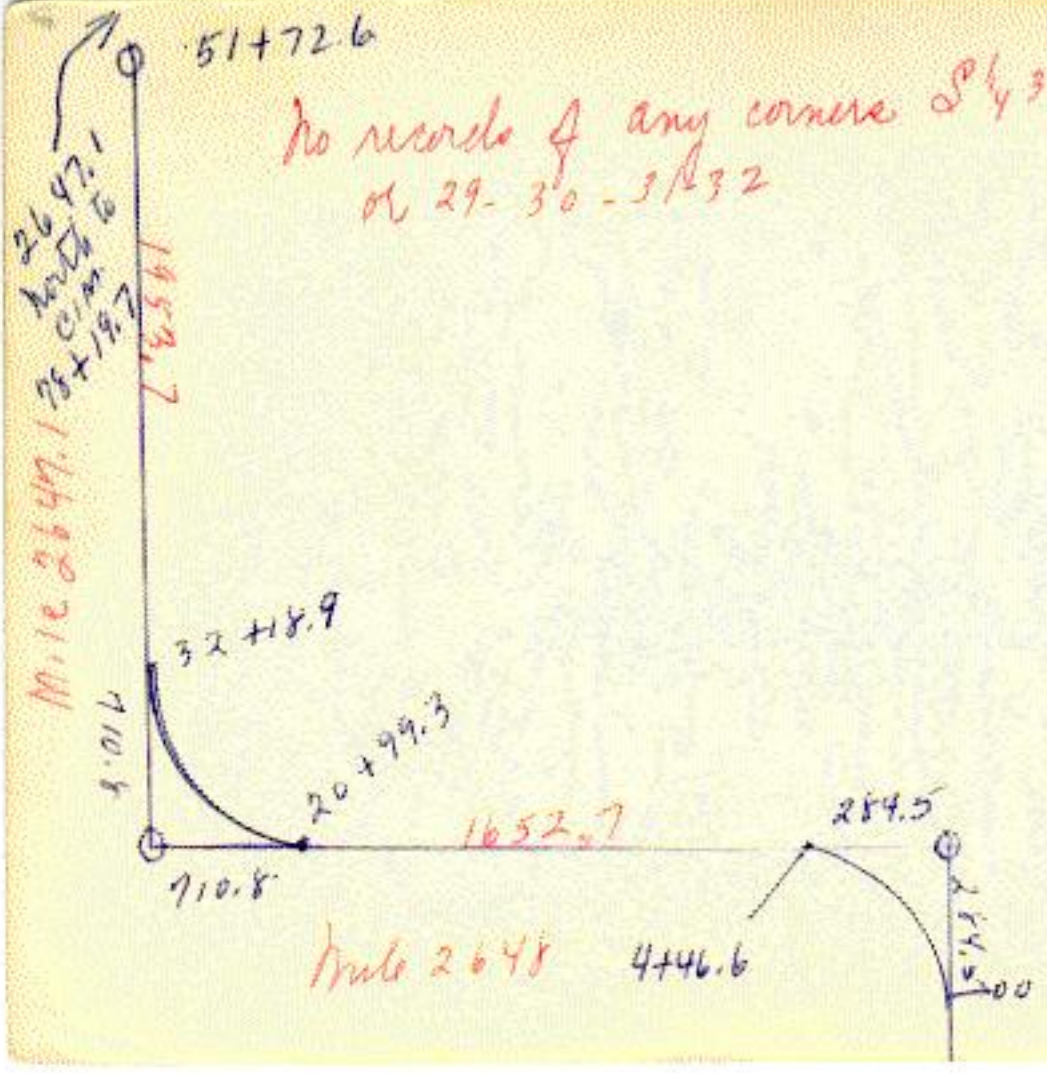
No records.

Co Hwy Dept 1939 Book 101 P2 & p. 75

hub reset over 2x10x28 limestone.

Spike power pole (brace) SW 38.0
" " " SE 40.2

Corner Sta - on PI 28+10.1
sta ½ 31-32 51+72.6
Meas east 2648.0 or (28+10.1 - 4+46.6 + 284.5) (PT Sta, Survey Mag)
Meas North 2664.5 or (51+72.6 - 32+16.9 + 710.8)


51+72.6
No records of any corners S¼ 32, S 31-32, ¼ 31-32
or 29-30-31 & 32
2647.1
North
C/M
75+19.7
1453.7
M.C. 2647.1
32+18.9
710.4
20+99.3
1652.7
284.5
710.8
Mile 2648
4+46.6
00

Card # 2 South 31-32 Dover 106-11 # 613205 (2)
North 5-6 Elmira 105-11

9-21-73 found Co HD RP's NW and NE
dug with backhoe and found recorded limestone
down less than 20 inches, broke off small piece of
corner and set C/N on top. should have broken
off more as top of C/N very shallow if not above
road surface. corner do set about .17 north and
.33 west of nail set from RP's ??
47.32 NW to Co HD dec SW ends PP 1872 up 3'
44 55 NE to Co HD dec SE ends PP 1908 up 2'
corner very near center crossroads

over

Gov't notes: 1853 - set Post for Corner - dug trench

B.T's	Burr Oak	10"	N 39°W	31 links
	Black oak	10"	N 68½°E	59 "
	Black oak	10"	S 30°W	65 "

7-8-96 So Sec Cor 31-32 106-11 Dover R
No. Sec Cor 5 - 6 105-11 Elm. RA
fd CIM in good shape 4" Deep in Int 60th St SE &
150th Ave SE