1 8-3-73 set C/N over orig stone & iron (1)
#620405
section corner 4-5-8-9 Eyota 106-12
C-1 3-10-75
5-1903 C Armstrong P46 B 24 A Randall etal
Corner gone. set stone 6x14x16 limestone center
crossroads. by meas according to govt manual.
Meas 24'45 to 24'44 39.83 each ½ mile short 17 lks.
Meas ~~W~~ E¼4 to SW cor 9. 39.89 each ½ mile short 11 lks.
- each set stone on line and 23.70 1564.2.
then 9.97½ - then 6.20 to 24'44 should be 39.83.
658.02 409.2

Cover

8-12-69 J Kerr meas from C/M at SE 4 west. set nail in Center 4 way cross roads at 5270.0 R 5260.2', did not R P nail or meas N, W or S. at that time. noted all fences concerned.


3-31-71 Co surv. reestablished eyeball ¼ fence line S at S¼4 or 2631.3 - remeasured to 5270 and reset nail and referenced. - Cont meas west using referenced nail as .00 to fence line running north at ¼ S-8 as used P 310 A and P 46 B.

P 46 B 39.83 or 2628.8 -1971 2632.7 some 6° to 8° slopes + 60°

RP to nail at cross roads

hard nail on SW side power pole (unnumbered) NW 43.1

" " " SE " # 15922 SW 41.4

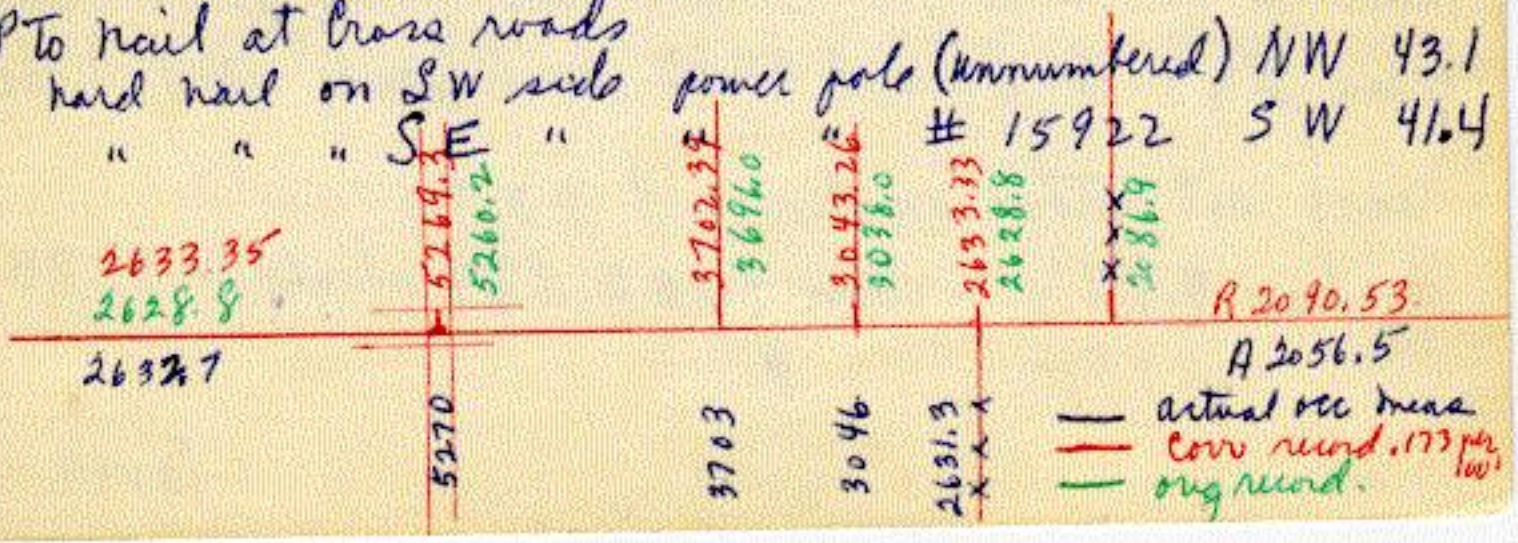

8-3-73 dug with tractor found near exact (2)
6 x 14 x 16 limestone down 2.6'. #620405
- drove iron rods on E. and W. sides of stone
with CIM over same. Corner - 4-5-8-9 Eyota 106, 12
Corner Cairn. 1.6 east 3.5 south of point set 3-1971 center crossroads
40.15 S.W. To conc nail on S side PP # 15922.
46.55 N.W. to conc nail on SW side tele pole up 6'.
84.0 NEly to natural bark seam between trunks of twin 14" and 18" burr oak below crotch on NW side.
Corner east and south of center crossroads above mean.

8-27-73 dug and found some evidence enough to create corners at 1/4 5-8 and 1/4 4-9. (over

at 1/4 4-9 found small piece wood stake on exact 26.4. line South of section corner 2' west of fence S. 1¼" Pipe
at 1/4 5-8 found dug area in proper place 4' west of fence north which could easily be site of orig corner. CM.

Meas west to 1/4 5-8.	2638.3.	R 2628.8. (to fence N).
Meas east to 1/4 4-9	2635.1.	R 2631.4
Meas 1/4 4-9 east to 3-4-9-10	2633.3	R 2628.8.

Set by William Jones 9-1853
80.00 set post at corner to sect. 4, 5, 8 & 9 deposited handful of charcoal made mound trench & pits & planted cherry seeds NE & SW