X

#620704 (1)

1/4 corner T-18 E yota 106-12.

5-1883 Hunter P382 no 373 & 7 H Morse, etal no B tree, found part stake on top ground. found stake remains in ground after search, set new stake -1/16 north set marked stake M & L. 19.84 1/2. N 35' E

6-1893 W Fraser P512 no 480 & 18 J Wilson, J Campbell. found stake set P382. left as found - no mark

---

10-1930 J Kerr B4 P10

corner gone set stone 3 x 3/8 x 28 on line (stake on side) corner came in wash. over)

- meas east to NE 18 2628.2
- meas west to NW 18 2526.8

51 55.0

burr oak N 11°20 W 27.0
12" " " ∠ 56°30 W 60.6
10" " " ∠ 60° E 76.6

Govt N line 18 78.56 - 5185.0
J Kerr 51 55.0

30' .5786 per 100

18.56 - 20 20 20
1224.96 1320 1320 1320 5185.
1217.87 1312.36 — 2624.72.
2530.23

X 12.2496 = 7.09'
X 1320 = 7.64.

#6207104 (2)

1/4 Corner 7-18 Eyota 106-12

Set by William Jones 9-1853

West on random line -

42.20 Brook 10 lks wide runs south 145.20

77.55 Brook 4 lks wide runs South

East on true line

38.56 Set post at qr ~~cor~~. sec. Corner


Red Oak 5 N 27 E 20


Red Oak 10 S 26 W 10

8-24-81 1/16 North : Dug from t.n. set on the North side of the corner post to fences West and South for 2½' North, 3' South, 2' East, and

1½' West by 2' deep to clay. Found the base of a post with cement poured around it 1.5 East of the nail. Found the remains of a small post 2.1 South and .6 West of the t.n. This was the oldest post in the area. Found nothing further.

8-24-81 1/4 Cor 7-8: Dug from a point 3' West of Kerr's stone as follows:

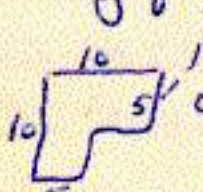

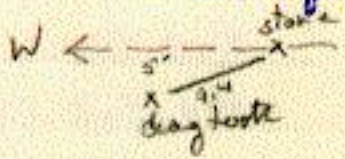

Found wire running west from the stone for 8' to 9' (it may have continued West if we had dug farther. The area appears to be in a slight cut of the old road running East and NW

1/4 Corner 7-18 Eyota 106-12 (3)
#620704

8-24-81 1/4 Cor 7-18 continued: The soil was all sand and easy digging. We did find a drag tooth lying down and down 1' appx 5' So and 8' West of the stone. Drove a lath here with stone around it to hold location since we had no instrument to determine more accurately. We were digging to cover Hunter's measure from the 1/16 fence North and line from the West at 1/4 Cor 6-7 over the fence corner at the 1/16 N (of 1/4 Cor 7-8) and also 1/4 line across Sec. 18 (Line from Calc. S 1/4 Cor 18 over the fence at 1/16 N and post found at Center 18.

7-26-82
5.46
7.34

9-1-82, 1/4 Cor 7-18: Dug from Kerr's stone, South for 6' and East for 15'. Did not find anything. Digging to cover Hunter's measure from the E-W 1/4 line Sec. 7 (using 2640 South of the stone found at NW7 as N-S for W'ly17). Hunter's full measure would come appx 5' South of Kerr. Also to cover a Will Fraser Center 18 which could have been East. of Kerr's on comparing measure to the W. 1/4 Cor 18.

7-26-82 Chained 1310± East From Kerr's stone to the Fence running South at the ½ E Kerr's stone is in line with the fence Farther E on the North side of the old road running East We chained 139½ West From Kerr's stone to the E bank of creek (East bank not nearly as definite as W. bank here) set nail 15.16 E of Kerr's stone and on Sec line