11-9-1964 set C/M over 1¼ x 16" pipe stones N-E-S sides ①

¼ corner. west ¼ 7 Eyota 106-12.
east ¼ 12 Marion 106-13.
#620706

5-1883 Hunter P382 No 373 & 7 H Morse, etal.
corner missing, no evidence or knowledge of corner.
- set temp point 40 chs south of NW cor 7.
- 16 south set stake 20 chs south of above meas.

12-1910 Chas Larson. P142B & 12. 8 parties found nothing as corner., set temp point for line west at 40 chs from NW 7. as Hunted did P382.
- set Center sec. 12 a limestone and found W¼ 12.

over.

10-1930 J Kerr B 4 P 10 thru 17A Sec 18.
did not set or search for corner but meas from W 1/4 18
to center railroad tracks to determine where to set ~~N~~ W cor 18.
2629.8' for each 1/2 mile

5-27-64 J Kerr. B 89 P 29. Robt Schoenfelder. S 12
Meas from ℄ rails north 1632' and from prop line ~~S~~ running north
on S line W 1/2 sec 6 106-12. 1220.34 and 1317.36 = 2537.7
dug and found small stones & wire. set NE 12 at that point.

B 89 P 70 ran line from SE 12 as set 1930 north
to C/M set above 3258.08 - set C/M as W 1/4 cor E 12
at 2629.04 R 1930 2629.8.

B 89 P 69. run line from W 1/4 12 east over C/M at center 12
set from. L stone set by Larson. line fell .17' north C/M set
as E 1/4 12. Proves C/M set very close to what Larson used for N-S

#6207060 (2)


West ¼ 7 Eyota 106-12

¼ corner


East ¼ 12 Marion 106-13

Gov. Notes 1853 Oct. Ball, Dep. Sur.
North between 7 and 12.
40.00 Set post and drove stake.

7-6-82, W. ¼ Cor 7: Dug with backhoe on the North side of Kerr CIM as follows:
found only one possible stake mark with reference appx 11½' North and 4½' West of the CIM but not definite at all.

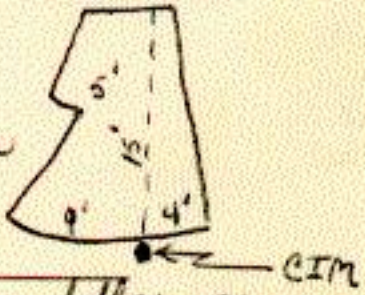

7-6-82, 1/16 South: Dug with backhoe as follows:
found nothing but a post mark 1.3 North and .4 East of the t.n.

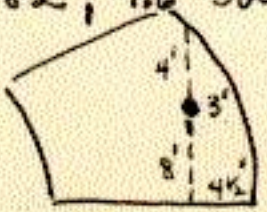

t.n. } N 5.84
t.n. } ESE 4.14