/ 7-22-85 CTA

#620904 (1)

1/4 corner 9-16 E yota 106-12.

8-1898 W Fraser P640 No 575 L16 Oscar Bear.

set small stake M & L 39.95 2636.7 L 89½ E

corner could not be found.

– bearing of 1/4 line south N 10' E

8-1969 J Kerr Joe & Pat. Meas east from Tie rod at center Crossroads at NW16 set small rail in line fence south. at 2650 R 2636.7 – 30.2 south to center tel pole. this road not maintained corner assumed gone.

5727.

7-1971 found undesignated stone boulder at 9-10-15-16.
Must find or reset. NW cor 16 8-9-16-17 or. find or reset
1/4 16-21. a sure corner and proj line N over center or use
1/16 S of center found & intera N line 16 and meas E to C1M
& Make NW 16 equal west. N-S 1/4 line 16 no picnic.

---


set by William Jones 9-1853
21.10 Br. Oak 5 in. diam.
39.94 Set post at qr-sec Corner — True line
Br. Oak 5 S 89 3/4 E 380
Br. Oak 8 N 85 1/2 W 560

6-20-85, 1/4 Cor 9-16: Dug as follows from the tranise nail (set in line with fence south and 13 1/2' north of the centerline of the E-W road):

See Card Z

1/4 Corner 9-16 Ejota 106-12 ②
#620904

Dug 4½' deep to clay. There was hard packed dirt at 4' deep when they used to drive. Mrs. McKenzie stopped and said before the present road was graded

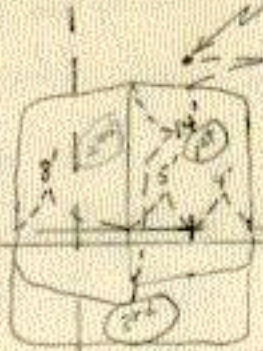

there was only a dirt trail here worn down in. Did not find Dill Frosen stake and no old corner post but have only dug 3'± South a straight line between section corners. Concentrated North 1st since 1/16 North and 1/16 South indicate a corner north of straight line (See Drwg 5-3A)

6-21-85 1/4 Cr 9-16: Dug from south edge of hole dug 6-20-85 to south edge of road. Found nothing. Condition poor here





7-22-85, 1/4 Cor 9-16: Set a 20" CIM over a 5/8" re-rod as the corner at the intersection of the line from the NW Cor 16 to the NE Cor 16 and from the S 1/4 Cor 16 over the Center 16 (See record corners)

1/4 Corner 9-16 Eyota 106-12 (3)
#620904

7-22-85 continued: Corner 1' South of the ℄ of the E-W road and 2' west of the fence line south.

RP's: Punch hole in top E. end CMP in field
drive SE 32.63
Punch hole in top W end CMP in field drive
SW 29.12

CSD in E. side pp# 493 NNE 34.82

Meas. West 2645.33. Meas. East 2627.91 Although corner not midway as intended by W. Fraser, corner being on line from S 1/4 Cor 16 (Fd) and Center 16 (Fd) we believe we have re-established Fraser's actual location and also Fall just 2' west of Fence line while midway post is 11' west of fence