/ 7-13-71 set CIM over 3/4" x 13" rod M&L 2636.42 ①

#621004

1/4 corner 10-15 E yota 106-12.

16-1872 Hunter p 209 no 217 L 10 H Hurlbert N. Coe - M Bowler.

Corner gone set M&L 39.97 1/2. L 89°55'E 2638.35

-1/16 each set stone M&L 19.99 (1319.34'11

see LE 10 a CIM card for 1/16 details.

-1/16 north set stake M&L 20.02

Meas N9-1966 2645.1 on N-S 1/16 line.

RR notes 3.04 chs north to L tracks 200.64'

5-21-70 Co surv. run & meas line from. cross in pavement at sec. cor. 10-11-14-15 as rel'd from. county grading books. over 1/16 stone meas 1319.45 R 1319.34. (over

set sight on short rod set 1968 as helper for finding 9-10-15-16
This rod meas 685.5± to ℄ tracks with R 10.42 687.72
- on projecting line found it missed about sight way north (est 30'
as record called for 4℄ like at 1/16 which it was legally and 4.93 at
SE cor 10 or 292.38 the CM was at 283.1 or about 9.28 (or
up to 1 link less) recorded on changing line to 1/16 stone and rod
at SW cor 10 and pushing each line came 8.85 north of trace
of SE 10. - believe how that SE to in error. - pushed meas west another
1319.45 set 1/2" x 3' rod on line between 1/16 stone & temp rod
at SW 10 which meas. 2636.17 R 39.97½. 2638.35 indicating
stone could be west some 2' and maybe some 2' south
- dug at 1/4 10-15 in railroad triangle 2' wide and 8' long to clay
covering all area of both lines mentioned - rod set bies
101.3 NNE to Tup cap PP #477 note this rod set to hold line
211.4 NW to pepsi cap PP #476. and meas subject to finding SW 10.

Card # 2. 1/4 10-15 Eyota 106-12 #621004 (2)

7-13-71 after finding 9-10-15-16. 7-6-71 re run line from 1/16 stone direct to corner found. using points of previous survey in 5-1970 for east-west measurements.

- set iron pipe up 3" on W side 1/16 stone east.
- set 1/4 10-15 1.93 Land 1.24 east of iron set 1970.
- placed CIM deep 10" or more over 3/4" x 13" reinf rod.

Meas E to 1/16 Nov 1318.21 - to lead slug in pavement 2636.42

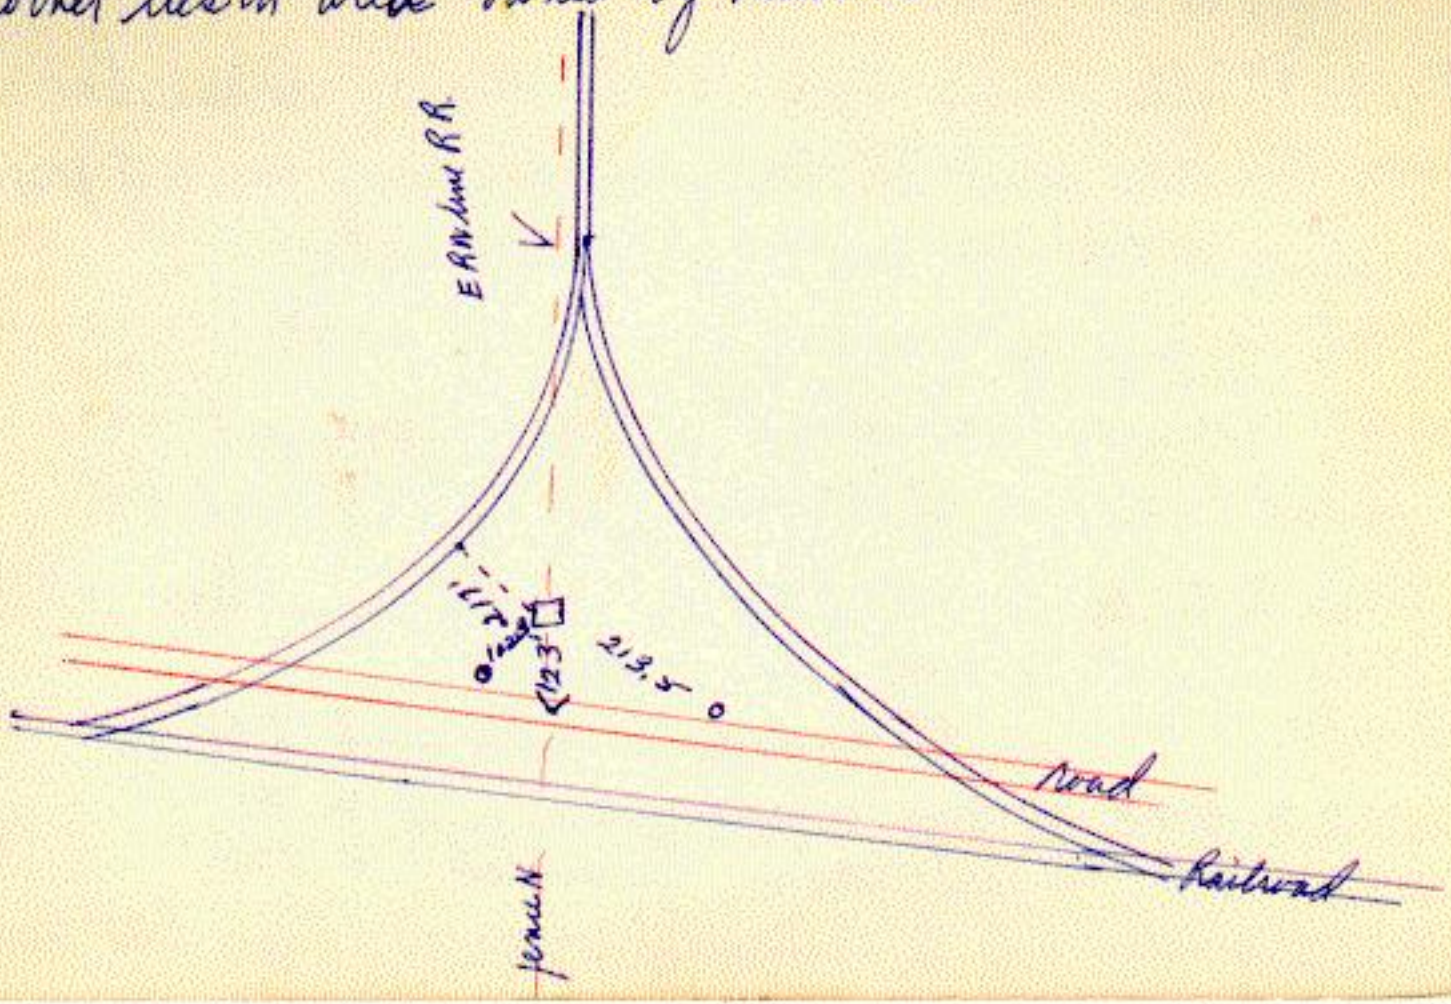
Meas W to CIM over stone 2636.42.

RP. - 1/4 10-15 123' ± Northerly to Center road ± 90° off road.

102.3 NNE to Top cap on power pole. # 477.

213.5 NW to pipe cap on power pole # 476. (over

217 ± southeasterly to west rail of wye curve RR spur ± 90° Main curve.


Corner lies in area owned by Railroad
E AN line R R
road
Railroad
fence N

#621004 (3)

1/4 Corner 10-15 Eyota 106-12
set by William Jones 9-1853
39.97½ Set post at qr. Sec corner deposited
6 white flint made mound & trench
& pits planted cherry seeds NW & SE.