#621904

1 7-24-68 set C/M over rod placed earlier. (1)

1/4 corner 19-30 Eyota 106-12.

3-1878 Hunter P332 No 326 D30 R Wasson, John Campion found stake hole lined with old bark from DW B T standing. set marked burr oak stake in to place.

- 1/16 west set stone 3x4x18 at 19.99½ on line (meas carefully 1 lk short Govt. meas) then 9.37¼ (618.6) to stone then 9.37¼ to sec cor stone.

1/16 Center NW¼ 30 set stake 19.97 M & L. N 20° W

6-1883 Hunter P384 No 375 D19 John Hughes.

found stake set P 332.


- meas east to sec cor stone 39.92.
- meas west " " " " 38.74. 2556.34

Bearing north to stone at center 19 N 5° W.

(over Williams survey)

6-1913 D Williams: P 222-3 B.
did not use 1/4 19-30 - coved
see entire mile. run this traverse
very carefully - set woodstakes. a Mr Neal.
and he would set steel stakes at Corners.

Mile Williams 5194.0
Hunter 5191.5

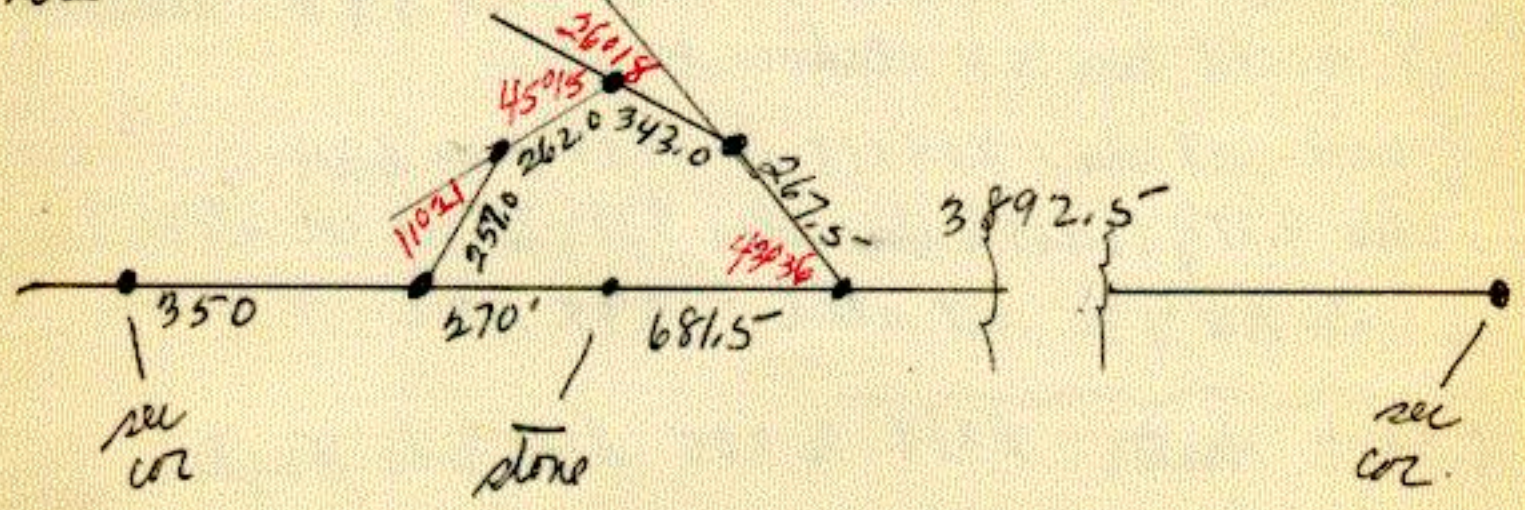

#621904 (2)

Extra card for ¼ 19-30 Eyota 106-12.
6-1968 J Kerr for Eyota town board.
Meas from LE19 to fence running south rough meas as former helped measure. came 2632 - record 2634+ dug extensively found place where old post of large size originally stood, nails staples etc. set rod in hole to hold spot.
looked for ⅛ stone west extensively with shovel and bulldozer. after brushing at LW 19 could see entire mile from about station 200 from east. found iron set to be slightly south 1.0' ± so set rod on direct line in

line fence south. abnt 2632 from ¼ E cor 19.
RPs as follows:
set ½" rod at 176.35' south then 176.35 set ½" rod
which came equally distanced between 2 large burr oaks
tall and 20"± dia. rod abnt 7' from each some
20 or 3' west of N-S fence. 7-24-68 set CIM.

1/16 west on securing line readily found 1/16 stone 3x4x15
set by hunter in 1878, it will be destroyed by road grading
RPs as follows: set 16D nail (bent in driving) in root of
14" white oak on east side 125.27 from stone. ther
on transit line set rod at 200' which came .8' north
of tree with deep rough bark. both trees lightly blazed
toward corner 7-24-68 reset with 3/4x12" rod before finish grade.
This corner lies 0.5 ± south of direct section line:
20 D-6' high W side 16" Bear 3' E of S 54.8 - 20 D 3' up 14" BO E side SE 54.6.

#621904 (3)

¼ Corner 19-30 Eyota 106-12

Set by William Jones 9-1853

14.10 Brook 3 lks wide runs NW

29.69 Br. Oak 6 in diam.

38.75 Set post at qr. Sec Corner -True line

62.40 Brook 8 lks wide runs North

68.80 Bend of same runs SW

71.00 Same brook runs North

8-23-95 FOUND 3/4" IRON SET BY C.H.D. IN 3-1994 FROM REF PIPE W/CAP.