1 9-5-93 set C/M ones stone found. (1)
Corr 3-7-75

1/4 corner 23-26 Eyota 10 6-12
M Madsen
7-1871 Hunter P186 No 197 S 14-23 J. Price #622304
found stake standing - B trees cut.
- Meas north 39.81 2627.46

8-1887 Hunter P421 No 410 S 23 James Price
found stake in center road small stone by side P 186
set stone deeper with stake by side.
- Meas north 39.81 N 1° E 2627.46

5-1902 H Fraser P14B S 26-27-34-35.
U Welch - V Welch - W Fallon - A Fordice - J. Tracy.
found stone in center road P421 2 rods N of post
- Meas west 39.74 - 2622.84 (over)

1/16 south set stone 9x9x20 M & L. 19.9± 1316.04
12" black oak S 26¼ W 52 links = 34.32'

4-29-1971 Co surv - Meas south from ¢ E-W roads on about 10' east of trashy fenceline. - set nail 12.3 in grave - & 10.5 from grass line R 1316.04 found recorded stone fully 9x9x20, a sandy yellow L stone. with top down 1 foot. fences in complete ruin - several ancient corner posts some 4" south. stone just on east side partly buried woven wire - drove 1¼" x 5' angle iron with rubber moulded to ends like common trailer bar - drove to bed rock some 3' dep. set on E side - Meas from ¢ road 1319.8 ±. ¼ stone could be in line fence and a little south of center road - center section could then be found and 1/16 stone west of center.

7-14-71 set Ho ⊙ center E-W-N roads. used as N-S aerial to set center 23. - Nail 5261.7 from CIM 1/4 23-26 R 5259.84


548 NW to SW cor tel box post - 330 S to fnce E post of Trail sign

Card # 2 1/4 23-26 Eyota 106-12 #622304 (2)
9-5-73 found nothing set 7-14-71. for line north when
set nail in center Tee Road. 5261.7 North to C/M at
1/4 14-23 R 5259.84
- dug with backhoe, found limestone very vertical with
4"x5" top with large wood stake. 8' West of stone.
stone down about 30", drove 1¼ x 14" pipe by stone
with glass - set C/M over stone (not stake.)
-Meas north to stone found at Center 23 2634.72
then 2632.46 to C/M at 1/4 14-23. all elect: meas
-Meas south elect taverse to center 1/16 stone 1315.93
then 1316.02 to stone found at Center 26. almost perfect line.
Meas east to 2"x4" stake found. - Slope 2641.18 0°5'20" North
Seefeldt Corke -

RPS ¼ 23-26 Eyota.

55.2 NW to small mark top center □ metal tele cable box with wood cedar post on N side to support metal cable post.

40.0' S to top of steel fence post broken off at top of spade driven flush in truck row S. post fence if any left at all in that area

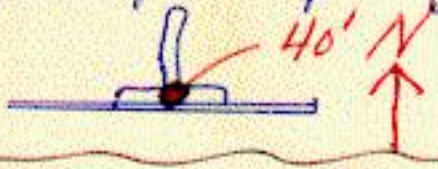

set by William Jones 9-1853

40.00 set post at qr. sec. corner

Br. Oak 5 N 86½ W 240

" " 6 5 7½ E 125