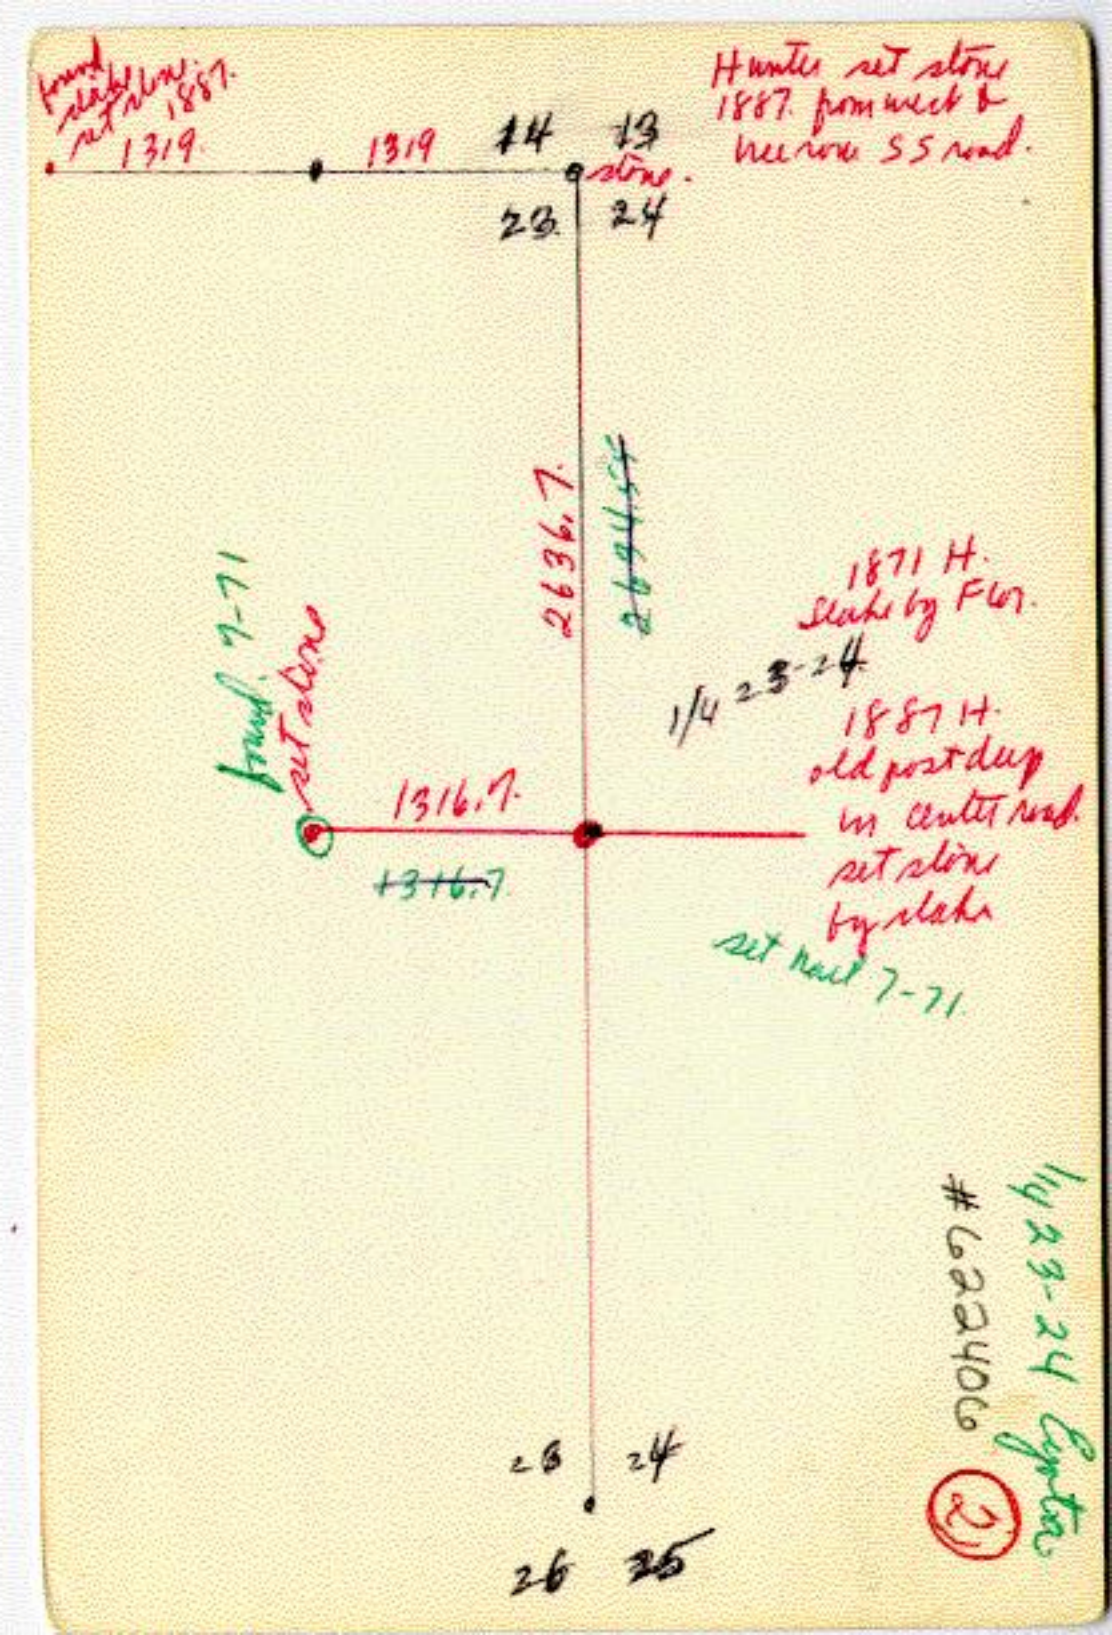
1 9-7-73 set C/M orig. 16" rod by line meas from ①
cor 1 3-7-75 #622406 west

1/4 corner 23-24. Eyota 10 6-12.
7-1871 Hunter P186 No 197 L23 m Madison
J. Price.
found old stake by fence corner no meas
Bearing line west L 89 3/4° W

8-1887 Hunter P421 No 410 L23. James Price
found part of old stake deep in center of road, built
since above. lines fence east agreed by John James
as true location of corner if not the orig corner dolf.
set stone with old stake by side
1/16 west set stone M & L. 19.95 1314.7 L 89° E.
— meas north 39.95 2636.7

7-14-71 Co surv. set 40 D at 2633' east of 40 D set at Center 23 on random N-S line set 90' S of nail set. 2642.35 S of C1M 1/4 14-23 -
- found 1/16 stone at 1316.4 east of Center nail set 100' S.
- 40 D nail came in fair line fence west and about 4 W ℄. 1983 - fence E. have only
- Meas north to referenced point at NE 23 untied point.
2634.55 1887 record 2636.7.
RP nail 30.87 E to ⁘ Send 18" field calc.
40.04 NE to single punch hole N end 18" field calc.
9-7-73 Lee Card 2.


found stake set below 1887.
1319.
1319
14
13
stone.
Hunter set stone 1887. from west & below SS road.
23
24
2636.7.
2644.2
1871 H. stake by FCH.
1/4 23-24
1887 H. old post dug in center road. set stone by stake
set nail 7-71.
found 7-71 set stone
1316.7.
1316.7
26
24
26
25
21

9-7-73 found. Center sec. 23 limestone pointing Corner.
Ran traverse from point South 4 1/4 23-24 to Center 23
and 1/16 stone found 7-1971. found to be 1317.88
- set 1/4 23-24 on computed line and double meas.
dug entired area with back hoe. road gone to clay. 3' dep.
drive. 16" reinf rod. with CIM. over. iron.
28.62 due E to punch holein S end. 18" top center field
Culv.
39.43 NE to same N end.
Meas north ± 2635.25.
South when taken to 23-24-25-26 when set.

#622406 (3)

1/4 Corner 23-24 Eyota 106-12

Set by William Jones 9-1853

40.00 Set post at qr. section corner deposited charred stake made mound trench & pits planted Br. Oak acorns NE & SW cherry seeds SE & NW.

47.60 Brook 5 lks wide runs East

75.25 Brook 4 lks wide runs East