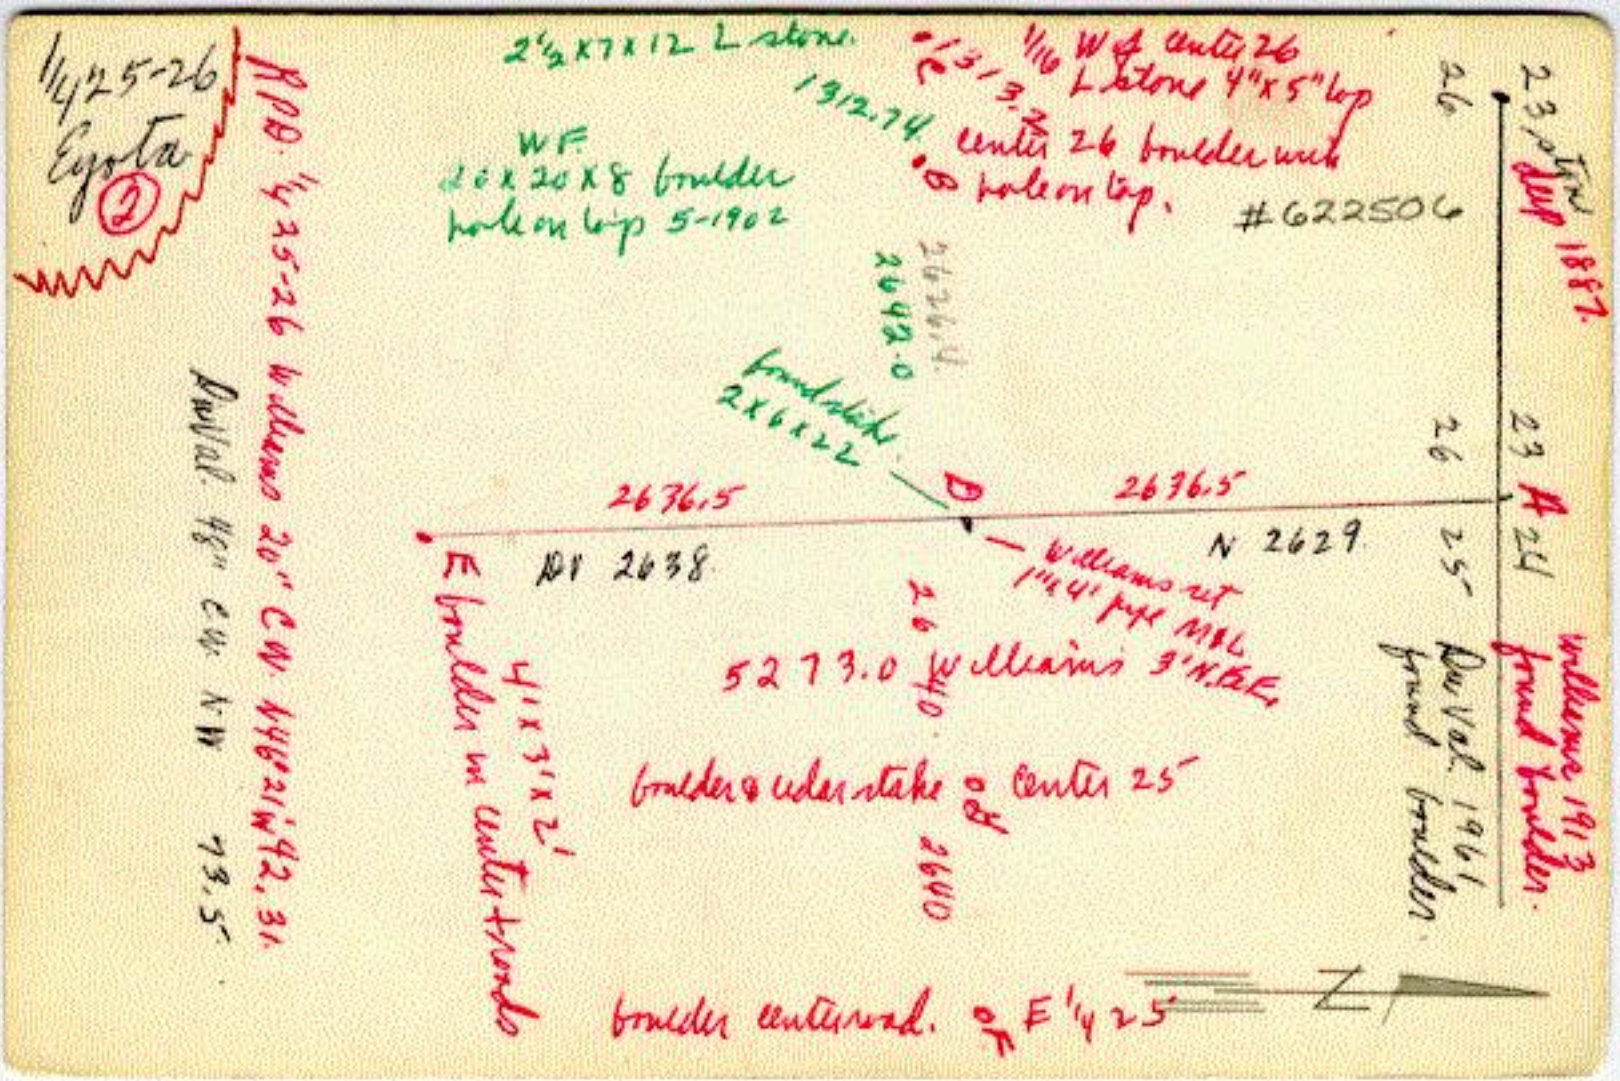
X 9-6-73 found H Fraser stone - set irons E-W each (1)
also found DuVal & D Williams line. left Williams stone 18" dup
#622506
1/4 corner 25-26 E York 106-12.
6-10-79 - set C.I.M. over 3/4" iron
3-1902 H Fraser P14B L 26-27-34-35 5 parties see N 1/4 26
found old stake in center road in line fence east
set stone 2x6x22 in place of stake.
- meas west 40.03 (2641.98) L 89°40' W.

6-1913 D Williams P224B L 25 Mall Keefe
Couldn't find corner or record of any survey above. tried to find corner at 2626.4 east of center for double distance from center to 1/16 west further meas Fraser 1312.74 compared with 1313.2 favorably - also dug 8'x4'x3' deep found center & 1/16 W both dug both OK
then meas 2640 from north and dug 8' square & 3' deep
then meas from E 1/4 25 over a bowlder with cedar stake beside it as
over

Center 25 and dug 4' deep arround this area.
Set 1" iron pipe 4' long as corner thus established & placed
buck arround it.
20" Cottonwood N 46° 21' W - 42.31'
this corner lay a "few" feet north of fence east at
west end but soon fell onto willow line further east
and 3 old fence post of old fence.
All indications seem true corner several feet south
and as much as 16' further east.
- Meas N & S 2636.5 - W 2626.4 - 1.85 line adj. or 2624.55
- Meas east 2640 to center 25 then 2640 to E¼ 25.

Munn H D DuVal 11-1961 found nothing used E-W fence
& ℄ road. set 3/4" rod - 48" Cottonwood NW 73.5 a MHD Disc
6" elm W 31.08 Disc MHD. - cor FP E 32.8 - MHD Disc
Meas N & S Duval - S 2638 N 2629 - Williams 2635.5 each.


1/4 25-26
Eyota
2
RPD 1/4 25-26 Williams 20" CW 44°21'W 42.31
Rwval 48" CW NW 73.5'
2½x7x12 L stone
WF
20x20x8 boulder
Iron in top 5-1902
13.2.74
1/16 W of cntr 26
L stone 4"x5" top
cntr 26 boulder mk
Iron in top.
#622506
2642.0
found stake
2x6x22
2636.5
2636.5
D
N 2629
N 2638
E boulder
Williams set
1"x4' pipe MBL
5273.0 Williams 3' N.E.E.
26
4'x3'x2'
boulder in cntr trench
2640
boulder cntr mrd.
E 1/4 25
23 pipe 1887
26
23
A 24
25'
Rwval 1961
found boulder
williams 1913
found boulder

9-5-73 dug north of R.W. fence with back hoe for stone set by Jr Fraker. found D Williams pipe and DuVal iron.
9-6 ran line from 1/4 26-27 as re-set over center 26.
then easily found limestone. 4.7' south of I 90 R/W fence.
at 2643.15 west of center 26 stone. R. 2641.98
grading had cut away just enough to place 1 stone 2" down
- set stone on east and west sides as temp guards.
DuVal rod lies 6.4 north and 2.5 west (pulled rod).
Dwilliamspipe lies 7.3 north and 6.0 west left down 18"
Meas north to 23-24-25-26 (2639.11

Card # 3. 1/4 25-26 Eyota 106-12 #622506 (3)
final RP3 to limestone set by Hill Fraser 5-1902.

42.3 NE to MHD reference monument
27.45 NW to NE corner of 4" □ metal tele cable post
5.45 N to N edge top rod barricade plank
4.7 N to woven wire of I 90 N R.W. fence.

---

set by William Jones 9- 1853
40.00 Set post at gr. section corner deposited handful of flint. Made mound trench & pits planted cherry seeds NE. & SW.

Survey Marker Sign post 1.0 North