#622605

X 11-17-1967 Co. set C/M over boulder etc. (1)
6-8-73 relocated point for corner from witness set working
section Corner- 26-27-34-35 Eyota 10 6-12.
11-31-1974 set a 1¼" Pipe as Corner
5-1902 W Fraser P14B S26-27-34-35 5 perches see N ¼ 26.
found. 3 stones set together for corner set large
boulder in place of stones 6 x 15 x 34
- Meas south 39.98 to corner stone N 45' W
- 1/16 west set stone 2 x 6 x 17 M & L 19.94½ 1316.37 N 89° 55 W
- 1/16 east set stone M & L 19.91 1314.06
- 1/16 north set stone 3 x 10 x 22 M & L 19.92½ 1315.05 N 30' W
- 1/16 center S E ¼ 27 set boulder at inters lines
- 1/16 center S W ¼ 26 set boulder 4 x 5 x 14 at inters lines

April 1863 P.C. Compton Pg. 68 No 96 Sec. Corner was gone Reset
from witness trees. used to set ¼ Cor 34-35 M&L

Co H Dept 1949

+ SW cor N headwall NNE 81.4 – Sp tele pole # 148 NE 58.9

Sp tele pole # 149 SW 38.1 – Sp power pole SE 54.1

– 1/16 east stone & iron bar Said Co H Dept. Book 165 –

Sp pine tree SE 52.2 – Sp 2nd fence post S 39.8

Sp tele pole - N.W. 92.7

1967 Co Hwy Dept lines after setting C/M.

Sp Rise tele pole NW 64.85

" tele pole. SW 52.16. road now straight.


Sp tele pole N 38.98.

Sp ~~line~~ cross in east end of north headwall box culv. ? 92.82'

1917 - C.H.D. Book # 19 page 20 Had a stone


#622605 (2)

Card # 2. 26-27-34-35 Eyota 106-12.
6-8-73. found position 1/16 stone west set by
H. Fraser. 2x6x17" could not find 1/4 27-34 as
it was in very wet area. Meas from C/M at
28-28-33-34 east to 1/16 stone 3948.66
- projected line east from POT set on true E-W 1/4 line.
1316.22. east of 1/16 stone found. meas last 360.8 with
chain. this point came 1.34 west of center cut in
pavement. and 6.3 NE ly to diagonal cross mark in jar.

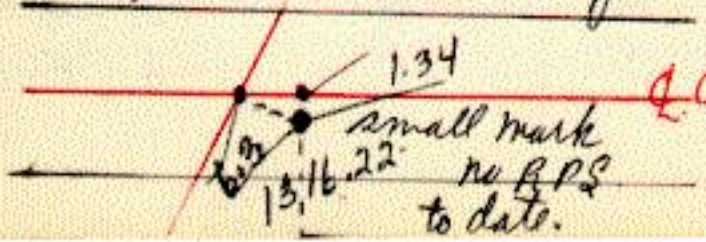

A to C.	2864.25.
C to D	1084.40.
A to D.	3948.65
C to B Comp	231.81
C to E	2041.15
E to D.	956.76
E to F.	359.46 to Mark.

A SW 27. in Place.
B. S 1/4 27 when set.
C P.O.T elect
D 1/16 corner in place.
E P.O.T elect
F SE 27 when set.

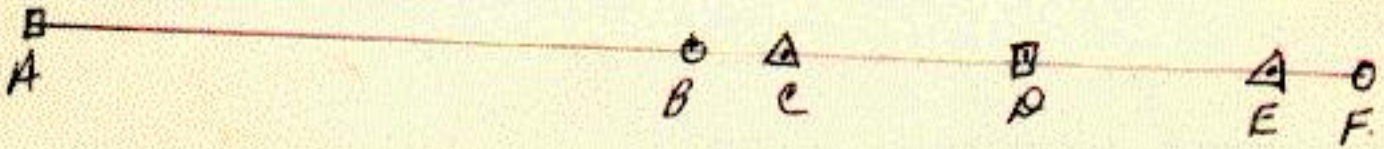

#3

Sec. Corners. 26-27-34-35 Eyota Twp. 106-12

8-27-74 #622605

Reran the South line Sec 27 + Reset the South 1/4 cor. Reset this cor. At 1316.21 from the 1/16 west. + on line from the S.W. cor 27 over the 1/16 E. of the S 1/4 cor. the new cor moved 0.18' South of the temp point.

R.P.'s

C.S.D. S.E. side P.P. # 1777 S.W. 52.01

C.S.D. N.W. side tele post with box N.E. 75.37

Large hole top S. and Large C.M.P. O S.E. 101.04

Gov. Notes 1853 Oct. 17.
North between 34 and 35.
80.00 Set post at corner to sect. 26-27-34-35.
Br. Oak 16 S 13 E 632
" " 6 S 3 W 576
" " 10 N 64½ W 524
" " 20 N 82 E 448

5-16-97 FOUND 1¼" PIPE IN GOOD CONDITION 1.3' W OF ℄ CR#7

5-23-97 SET 1" SQ PIPE/CAP AS REF IN FIELD DR N ON CR 129 W. 19' N ℄ CR#129. 6' E ℄ FIELD DR.

✓ (622605)

6-25-99
MWD RF AE

Sec Cor 26-27-34-35 106-12 Eyota 51
found 1¼" pipe 1.3 west of ℄ CR #7

TA@ Ref pipe Set (5-1997)
ΔRt OVERPASS to (622605)
84°35'18" dh01 86°20'17" dh02
0°01'00" dh00 1°46'04" dh00
84°34'18" 84°34'13" Δ = 84°34'15.5"

TO OVERPASS (2078)
VA 89°34'52" dh05
Slope 2184.710 Hor 2184.65

To Sec Cor 26-27-34-35 (1¼" pipe
VA 91°56'35" dh04
Slope 303.055 Hor 302.88

ΔRt PK in PP (No #) (pole in SW Cor
Int CR #7 & CR129) to Sec Cor
26-27-34-35
350°48'26" 352°12'20"
0°02'58" 1°26'52"
350°45'28" 350°45'28"
Δ = 350°45'28"