/ 6-7-1973 set 120 Ø on N-S 1/4 line. ①

See card #3 for 1/16 N & S. #622709

1/4 corner. Center 27 Eyota 10 6-12.

5-1902 W Fraser P14B & 26-27-34-35 5 parties on N 1/4 26.

set stone 2 x 10 x 24 at inters lines of all 1/4 corners

-1/16 north set stone 6x6x18 M&L. 19.94 1316.04


-1/16 east set boulder M&L. 19.94 1/2 1316.37 N 89° 33 W

-1/16 south set boulder M&L. 19.94 1316.04

-1/16 center & E 1/4 27 set boulder inters lines - (no meas).


6-7-73 found 1/4 22-27, and 1/16 stones N and S of once set center 27. now removed in I 90 Const. dug large area on I 90 R.W. for above stone and found everything removed and filled with huge boulders.

and then reconered with thin layer of black dirt.
- entire N-S line on 45' offset west direct from.
both 1/16 stones boulders in west virgin areas and.
adjustment to meet 45.66 meas at 1/4 22-27 would
change very little the original offsets, all on stones
found. - set 120 D as center 27 by meas line
and meas from computed figures. See Card # 2.
RPS on Card # 2

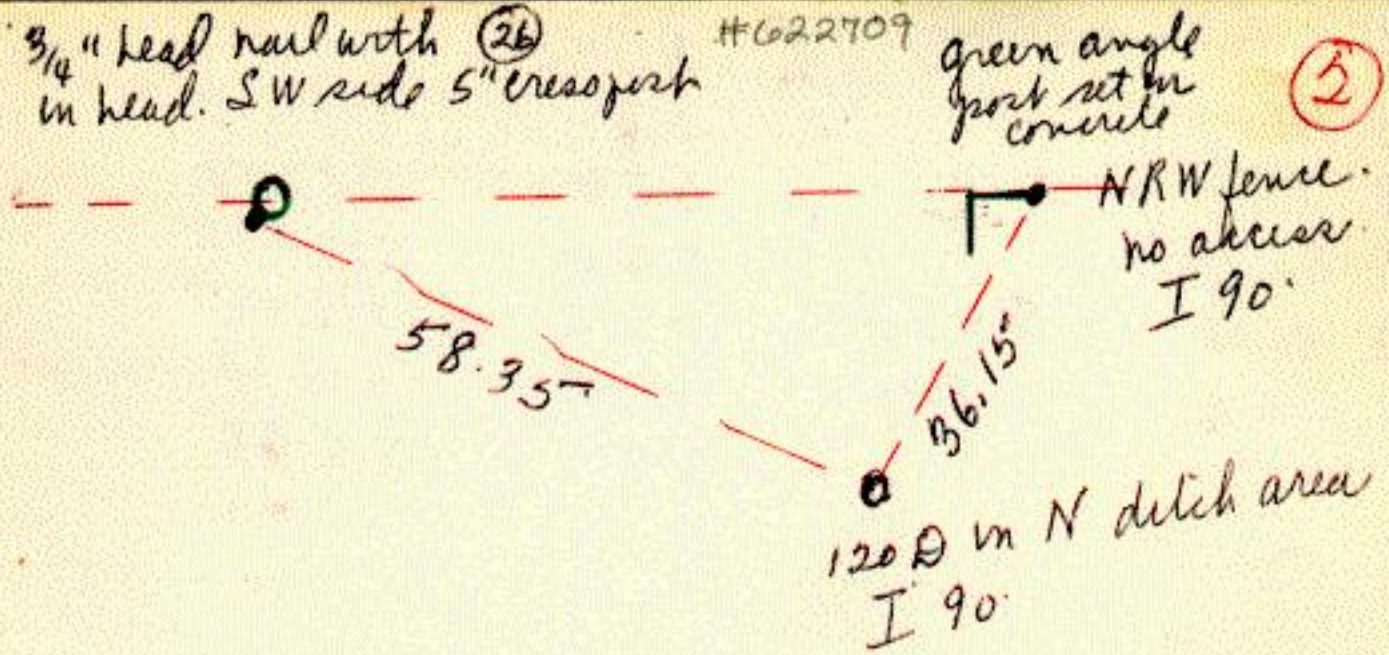
3/4" lead nail with (26) in head. SW side 5" cresoport
#622709
green angle post set in concrete
(2)
NRW fence. no access I 90.
58.35'
36.15'
120 D in N ditch area I 90.

A ± point on 45' proj offset.
B RR spike " 90°.
C P.O.T. transit "
D RR spike on " 90°.
E 45.66 45' ⑤ E to stone.
B, D, E corrected to 90° final mean

A to C	2561.13.
B to C	1244.75.
C to D	1387.58.
B to D.	2632.33.
D to E.	1316.55
A to E	5264.26 adj to "A" final
A to B	1316.38 " "

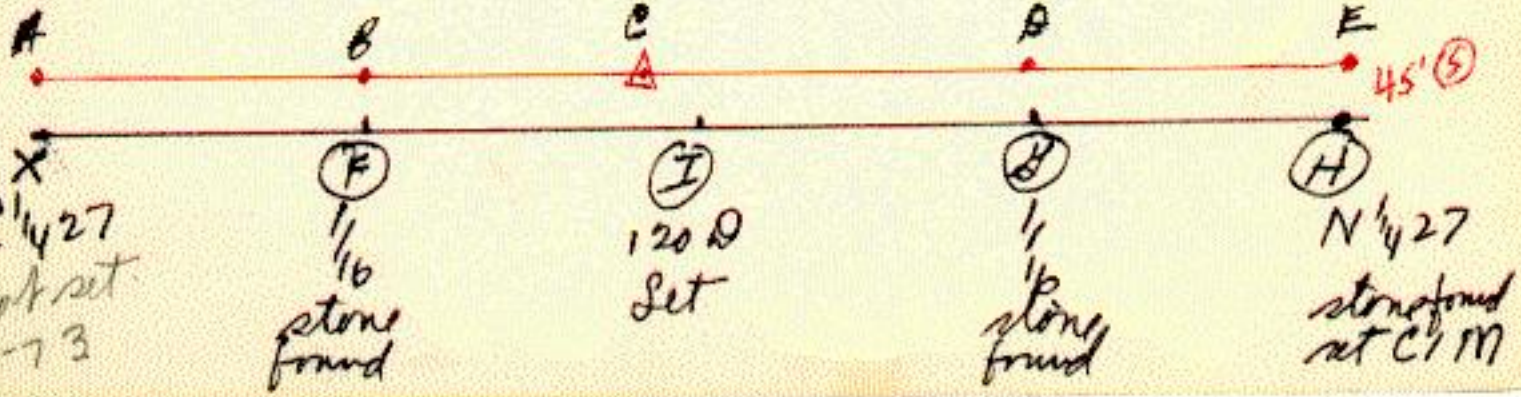

Card # 3 Center 27 Eyota 106-12. 1/16 corner (3)
#622709

1/16 corner south or N & L between Center 27 & 1/4 27-34
Record a boulder set 5-1902 by Jr Fraser P146 1316.04.
6-5-73 found pointed boulder in real wet soil & brush.
this corner could shift E or W to align line if needed.
4.15 E to bottom wire of woven wire.
5.5 SE to wired up corner post
Corner stone in fair line main fence running E.
Lee Card # 2 for Meas to date. 8-8-73

1/16 corner between Center 27 and 1/4 22-27 Eyota

found recorded. 6 x 6 x 18 Set by 2Lt F Fraser 5-1902
P 14B.

set steel post on S side with many
limestones piled around it.
this 1/16 stone much more stable than 1/16 stone
south of center 27. See Card # 2 for meas. etc.

May, 1856 Thos Hunter pg. 6 No. 10 shows Center Sec. with 2 bearing Trees.
(N 76 1/4° W 297 links) & (N 7 3/4° W 164 links).
1/16 west 19.99 chs. m&L - two B.T.'s (N 49 3/4° E 40 5 lks.) & (N 31 3/4° W 324 lks)
1/16 North 19.94 chs. m&L - two B.T.'s (N 50 3/4 E 127 lks.) & (N 25 1/4 W 55 lks)
meas. South 39.76 chs. to 1/4 Post
N-S 1/16 line in S.W. 1/4 Meas. 39.84 chs.
E-W 1/16 line in N.W. 1/4 Meas. 39.83 chs.