1 6-5-1973 set C/M over bridge bolt and plaster backs of old T.V. bolts (1)

#623304

cont 3-11-75

1/4 corner. south 1/4 33 Eyota 106-12

north 1/4 4 Orion 105-12

8-1856 Hunter P16 no. 25 d-d1/2 33

used corner.

1/16 east 19.99 M & L. N 89 1/2 E 1319.34


1/16 west 19.87 M & L N 89°35'E 1311.42.

1/16 north 19.92 M & L N 1°10' W. 1314.72.

1/16 center d E 1/4 11. 19.96 N 10 5 W 1317.36 of 1/16 cor on town line

1/16 center d W 1/4 11. 19.96 N 89 3/4° E 1317.36 of 1/16 cor on west line d 33.

over

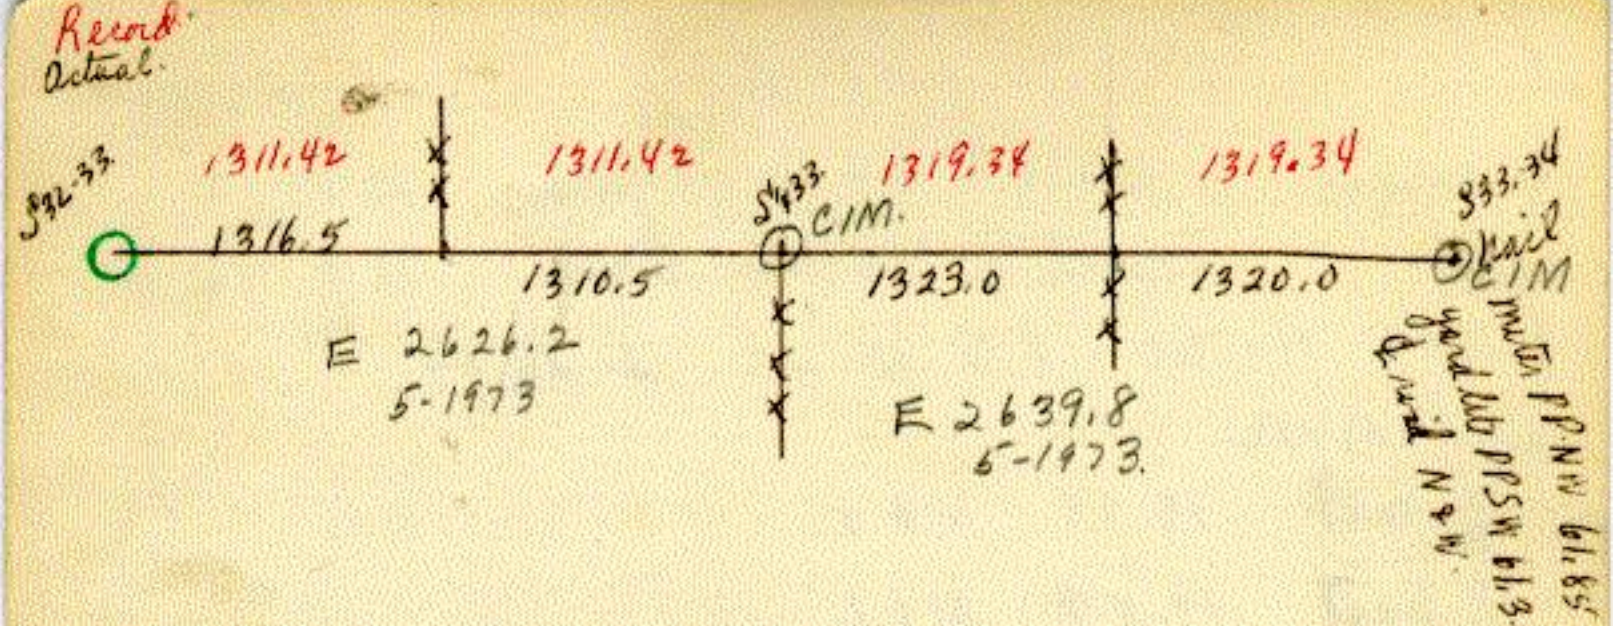

Gov. Notes 1853 Oct. Ball, Dep. Sur.
West between 4 and 33.
40.00 Set quarter post.
Br. Oak 8 in. S57W 62 lks.
Br. Oak 10 in. N56W 167 lks.
41.20 Brook 2 lks. Wide runs south.

Card # 2. S 1/4 33 Eyota 106-12. #623304 (2)
N 1/4 4 Orion 105-12

6-5-73 ran electronic line from. CIN at S 32-33 over random Nail at S 1/4 33 area in Center road and in line fence south. also ran traverse from point on true direct E-W 1/4 line about 880' west of Center 33 to 1/16 fence running east south & Center 33. or 1318. computed. which made center road at S 1/4 33.

Near. 2646.38 from E-W 1/4 line.

- dug with backhoe. on N edge road to within 4' of &. found dark dug area 20" diameter down 3' with small boulders in center. 11.38 north of center line random nail set. 3/4" x 18" Bridgeport and 2" x 2" hub. and plastic backe of 2 T.V. sets with CIN above.

over.

final Meas. North to 1/16 fence east 1317± then
1318± north to E-W 1/4 line as now used.
(CIM over stone at 1/4 33-34, iron M & L at 1/4 32-33)
– west to CIM set by J Kerr 2626.2 (re dug 6-1973 no other found.)
east to CIM set by 2639.8
evidence of dug area & small boulder

52.9 WNW to Conc nail driven into Concrete layer added to top west edge west headwall. about .4' from west edge headwall.
36.5 4' W & N to bottle Cap on E edge tele pole.
53.79 S. to 20 D top corner post die south of corner.